

MISSISSIPPI DEPARTMENT OF NATURAL RESOURCES

Bureau of Land and Water Resources

Southport Mall

P.O. Box 10631

Jackson, Mississippi 39209

WATER WELL DRILLERS LOG

PEARL RIVER  
E63

CODED

Griner Drilling Service, Inc.

Pearl River

6-28-86 date well completed

firm name

county well located

LANDOWNER:  
Prosper Energy Corp.  
P.O. Box 4096  
Houma, La. 70361  
(mailing address)

description of formations encountered

from

to

Top Soil	0	10
SAND, gravel	10	84
CLAY	84	147
SAND	147	252
CLAY	252	276

WELL LOCATION: 1135' S 1098' W

sec. 35 T 2 N R 17 E NE

cor. (S) (W)


Poplarville, Miss. (direction) (nearest town)

WELL PURPOSE: oilfield no supply  
(home, irrigation, municipal, industrial)

WELL COMPLETION DATA:

- (1) diameter (inches) 4"
- (2) total depth (feet) 276'
- (3) static water level (feet) 30' (below) above top of ground.
- (4) casing steel, 252' (material) (depth)  
4" (size) If telescope see back.
- (5) screen 42', 210' (length) (depth to top)  
4" perforated (size) (material)
- (6) pump - 95 (HP) (yield gpm)  
AC (type power)
- (7) electric log (yes or no)

CODED

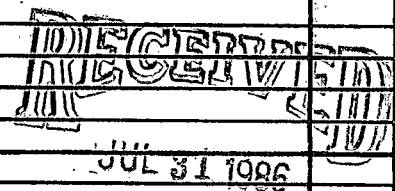

Department of Natural Resources  
Bureau of Land & Water Resources


(organization running log)

(8) how well bottom plugged ORANGE peel

DRILLERS REMARKS:

If well telescopes please sketch and show depths.

GROUND LEVEL

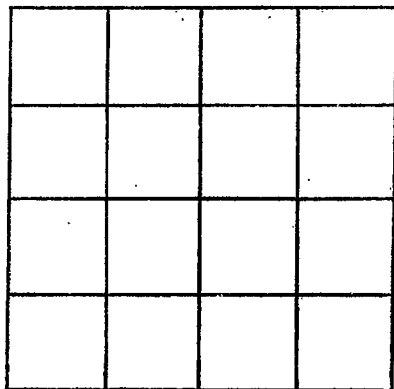

SECTION \_\_\_\_\_

Please indicate well location X.

ADDITIONAL INFORMATION

If more than one screen,  
show locations of each on sketch.