

Pearl River
E 64
6-67

MISSISSIPPI
BOARD OF WATER COMMISSIONERS
416 North State Street
Jackson, Mississippi 39201

WATER WELL DRILLERS LOG

6-14 1967 Panton Well serv Pearl River
date well completed firm name county well located


LANDOWNER: J. D. Wheat
Rt 1 New - No Box
P.O. Office @ Poplarville
Poplarville Miss
(mailing address)

description of formations encountered	from	to
	Red clay	0
Sand & Gravel	40	68
Blue Clay	68	162
Grey Sand	162	195

WELL LOCATION:
OK (9) T 2 S R 18 W
7 miles North of Cross Roads
(distance) (direction) (nearest town)

WELL PURPOSE: Home
(home, irrigation, municipal, industrial)

- WELL COMPLETION DATA:
- diameter (inches) 2"
 - total depth (feet) 195
 - static water level (feet) 12 above top of ground.
 - casing Galv 190'
(material) (depth)
(size) if telescope see back.
 - screen 5' 190'
(length) (depth to top)
012 2" S. Steel
(size) (material)
 - pump ✓ ✓
(HP) (yield gpm)
(type power)
 - electric log NO
(yes or no)
(organization running log)
 - how well bottom plugged BW Valve

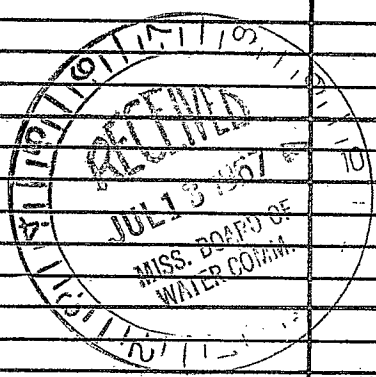

DRILLERS REMARKS:

