

MISSISSIPPI DEPARTMENT OF NATURAL RESOURCES

Bureau of Land and Water Resources

Southport Mall

P.O. Box 10631

Jackson, Mississippi 39209

WATER WELL DRILLERS LOG

Griner Drilling Service, Inc.

Caled Pearl River

PEARL RIVER  
E 66  
7-22-86

date well completed

firm name

county well located

LANDOWNER:

Prosper Energy Corp.  
P.O. Box 4096  
Houma, La. 70361  
(mailing address)

description of formations encountered

from

to

WELL LOCATION:

Poplarville  
sec. 15 T 2 N R 17 E  
No. 2 G.H. (S) (W)  
15 miles (direction) of (nearest town)  
15-10 observation

clay, sand 0 90  
sand, pea gravel & gravel 90 340

WELL PURPOSE:

ditched supply well (home, irrigation, municipal, industrial)

clay & sand streaks 340 575  
sand & black pea gravel 575 625

WELL COMPLETION DATA:

(1) diameter (inches) 4"  
(2) total depth (feet) 700'  
(3) static water level (feet) 75' below top of ground.

clay 625 632  
sand 632 645  
clay, little sand 645 700

(4) casing 700' steel (material) (depth)  
4" (size) if telescope see back.

(5) screen 63' 637' (length) (depth to top)  
4" perforated (size) (material)

(6) pump - 80-85 (HP) (yield gpm)  
AC (type power)

(7) electric log (yes or no)  
(organization running log)

(8) how well bottom plugged orange  
peel

RECEIVED


OCT 16 1986

Department of Natural Resources  
Bureau of Land & Water Resources

DRILLERS REMARKS:

If well telescopes please  
sketch and show depths.

GROUND LEVEL

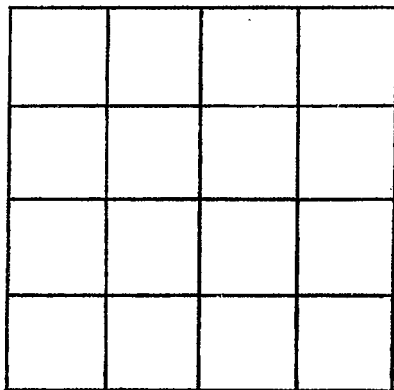

SECTION \_\_\_\_\_

Please indicate well location X.

ADDITIONAL INFORMATION

If more than one screen,  
show locations of each on sketch.