

MISSISSIPPI DEPARTMENT OF NATURAL RESOURCES

Bureau of Land and Water Resources

Southport Mall

P.O. Box 10631

Jackson, Mississippi 39209

WATER WELL DRILLERS LOG

Griner Drilling Service, Inc.

Pearl River

PEARL RIVER  
E 67  
7-23-86

Calbed

date well completed

firm name

county well located

LANDOWNER:

Prosper Energy Corp.  
P.O. Box 4096  
Houma, La. 70361  
(mailing address)

description of formations encountered

from

to

gravel 0 315  
Clay, streaked sand 315 1000

WELL LOCATION:

sec. 15 T. 2 N. Poplarville, R. 17 W. Field  
No. 2 G.H. Williams Observation  
15 mi. W. of (distance) (direction) (nearest town)

WELL PURPOSE: oilfield supply  
(home, irrigation, municipal, industrial)

WELL COMPLETION DATA:

- (1) diameter (inches) 3"
- (2) total depth (feet) 1000'
- (3) static water level (feet) 30' below top of ground
- (4) casing steel 315' (material) (depth)  
3" (size) If telescope see back.
- (5) screen 63' 252' (length) (depth to top)  
3" perforated (size) (material)
- (6) pump — 70 (HP) (yield gpm)  
AC (type power)
- (7) electric log (yes or no)

RECEIVED

OCT 16 1986

(organization running log)


- (8) how well bottom plugged Orange peel

Department of Natural Resources  
Bureau of Land & Water Resources

DRILLERS REMARKS:

If well telescopes please sketch and show depths.

GROUND LEVEL

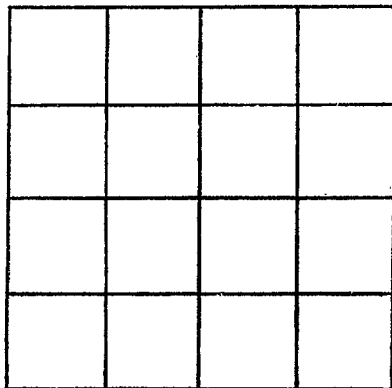

SECTION \_\_\_\_\_

Please indicate well location X.

ADDITIONAL INFORMATION

If more than one screen,  
show locations of each on sketch.