

MISSISSIPPI DEPARTMENT OF NATURAL RESOURCES

Bureau of Land and Water Resources

Southport Mall

P.O. Box 10631

Jackson, Mississippi 39209

WATER WELL DRILLERS LOG

Griner Drilling Service, Inc. Pearl River

PEARL RIVER
E 68
10-1-86

10-1-86 date well completed

Griner Drilling Service, Inc. firm name

Pearl River county well located

LANDOWNER:	description of formations encountered	from	to
Prosper Energy P.O. Box 4096 Houma, La. 70361 (mailing address)	clay	0	42
	streaked	42	126
WELL LOCATION: 1750' N + 1500' W sec. 12 T 2 N R. 17 E SE 1/4 of No. 1 Poplarville Field (distance) (direction) (nearest town)	clay	126	210
	streaked	210	294
WELL PURPOSE: oilfield supply (Home, Irrigation, municipal, industrial)	sand	294	441
WELL COMPLETION DATA:	pea gravel	441	483
(1) diameter (inches) 4"	SAND	483	525
(2) total depth (feet) 609'	streaked	525	609
(3) static water level (feet) 80' below top of ground.			
(4) casing steel 525' (material) (depth) 4" (size) if telescope see back.			
(5) screen 42' 483' (length) (depth to top) 4" perforated (size) (material)			
(6) pump - 90-100 (HP) (yield gpm) AC (type power)			
(7) electric log (yes or no)			
(organization running log)			
(8) how well bottom plugged orange peel			

RECEIVED


OCT 16 1985

Department of Natural Resources
Bureau of Land & Water Resources

DRILLERS REMARKS:

If well telescopes please sketch and show depths.

GROUND LEVEL

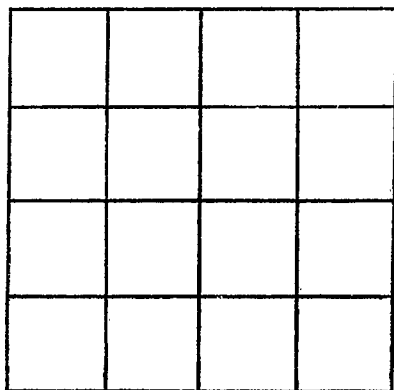

SECTION _____

Please indicate well location X.

ADDITIONAL INFORMATION

If more than one screen,
show locations of each on sketch.