

PEARL RIVER
E 69

MISSISSIPPI DEPARTMENT OF NATURAL RESOURCES
Bureau of Land and Water Resources
Southport Mall
P.O. Box 10631
Jackson, Mississippi 39209
WATER WELL DRILLERS LOG

Oct 12 1986 date well completed
Clear Well Drilling, Inc. firm name
Pearl River county well located

LANDOWNER: Phillip Vernado
Cross Road's
Mrs.
(mailing address)

WELL LOCATION:
sec. 11 T. 2 N. R. 18 E. Jg
9 miles NE Bogalusa
(distance) (direction) (nearest town)

WELL PURPOSE:
(home, irrigation, municipal, industrial)

WELL COMPLETION DATA:
(1) diameter (inches) 2"
(2) total depth (feet) 315'
(3) static water level (feet) 26' below top of ground.
(4) casing PVC, 305' (material) (depth)
2" (size) if telescope see back.
(5) screen 10' length, 205' depth to top
-010 PVC (size) (material)
(6) pump (HP) (yield gpm)
(type power)
(7) electric log (yes or no)
(organization running log)
(8) how well bottom plugged SS.

description of formations encountered	from	to
Top Soil	0	12
Gravel + Sand	12	95
Blue Clay	95	185
Sand	185	188
Blue clay	188	220
tan clay	220	275
Blue Clay	275	295
Gravel + Sand	295	315

RECEIVED


NOV 21 1986

Department of Natural Resources
Bureau of Land & Water Resources

DRILLERS REMARKS:

If well telescopes please
sketch and show depths.

GROUND LEVEL

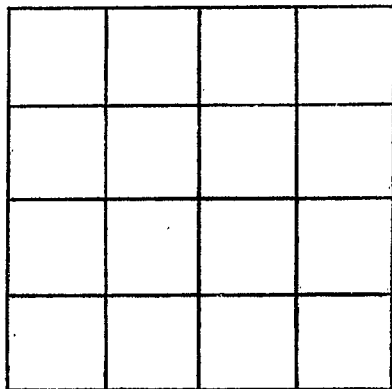

SECTION _____

Please indicate well location X.

ADDITIONAL INFORMATION

If more than one screen,
show locations of each on sketch.