

PEARL RIVER
E 70

MISSISSIPPI DEPARTMENT OF NATURAL RESOURCES
Bureau of Land and Water Resources
Southport Mall
P.O. Box 10631
Jackson, Mississippi 39209
WATER WELL DRILLERS LOG

CODED


11-2-86 Griner Drilling Service, Inc. Pearl River

date well completed firm name county well located

LANDOWNER:	description of formations encountered	from	to
EXXON CO., USA P.O. Box 60006 New Orleans, La. 70160 (mailing address)	CLAY, SAND	0	63
	SAND	63	90
WELL LOCATION: 2100' N & 3000' W sec. 25 T 2 N R 17 E of No. 4 Poplarville Field SOUTH DIST. (distance) (direction) (nearest town)	CLAY, SAND	90	231
	SAND	231	273
WELL PURPOSE: oil field rig (home, irrigation, municipal, industrial)	CLAY	273	325
	SAND	325	455
WELL COMPLETION DATA:	CLAY, SAND	455	570
(1) diameter (inches) 4"			
(2) total depth (feet) 570'			
(3) static water level (feet) 53' below top of ground.			
(4) casing steel 451' (material) (depth) 4" (size) If telescope see back.			
(5) screen 20' 431' (length) (depth to top) 4" stainless (size) (material)	Water Well		
(6) pump 5 90-100 (HP) (yield gpm) 230 volt 3 phase (type power)	No. 1 on		
(7) electric log (yes or no)	location		
(organization running log)	RECEIVED		
(8) how well bottom plugged 4" back wash valve - wood plug	DEC 19 1986		
DRILLERS REMARKS:	Department of Natural Resources Bureau of Land & Water Resources		

If well telescopes please sketch and show depths.

GROUND LEVEL

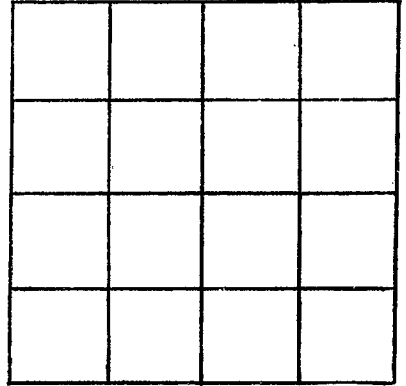

SECTION _____

Please indicate well location X.

ADDITIONAL INFORMATION

If more than one screen,
show locations of each on sketch.