

MISSISSIPPI DEPARTMENT OF NATURAL RESOURCES

Bureau of Land and Water Resources

Southport Mall

P.O. Box 10631

Jackson, Mississippi 39209

WATER WELL DRILLERS LOG

Griner Drilling Service, Inc.

Pearl River

Pearl River
E. 71

CODED

11-2-86
date well completed

Griner Drilling Service, Inc.
firm name

Pearl River
county well located

LANDOWNER:
Exxon Company USA
P.O. Box 60006
New Orleans, La. 70160
(mailing address)

description of formations encountered	from	to
<i>clay, sand</i>	<i>0</i>	<i>63</i>
<i>sand</i>	<i>63</i>	<i>90</i>
<i>clay, sand</i>	<i>90</i>	<i>231</i>
<i>sand</i>	<i>231</i>	<i>273</i>
<i>clay</i>	<i>273</i>	<i>325</i>
<i>sand</i>	<i>325</i>	<i>455</i>

WELL LOCATION: *2100N + 3000W*
sec. *25* T. *2* N. R. *17* E. of
No. 4 *Southern* *Poplarville*
Mississippi miles (direction of nearest town)
Field

WELL PURPOSE: *oilfield rig*
(home, irrigation, municipal, industrial)

WELL COMPLETION DATA:


- (1) diameter (inches) *4"*
- (2) total depth (feet) *451'*
- (3) static water level (feet) *53'* (below top of ground)
- (4) casing *steel* *451'*
(material) (depth)
4" if telescope see back.
(size)
- (5) screen *42'* *409'*
(length) (depth to top)
4" *perforated*
(size) (material)
- (6) pump *90-100*
(HP) (yield gpm)
AC
(type power)
- (7) electric log (yes) (no)
- (organization running log)
- (8) how well bottom plugged *orange peel*

CODED.

Water Well

No. 2

on location

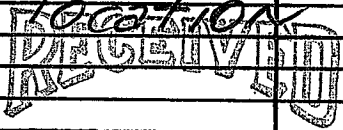


DEC 9 1986

Department of Natural Resources
Bureau of Land & Water Resources

DRILLERS REMARKS:

If well telescopes please sketch and show depths.

GROUND LEVEL

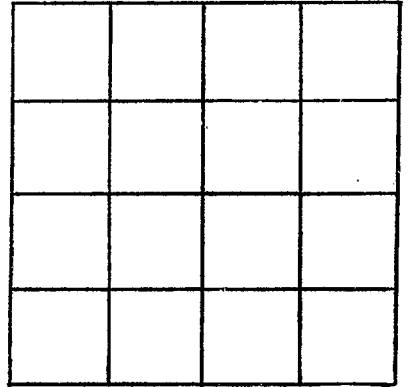

SECTION _____

Please indicate well location X.

ADDITIONAL INFORMATION

If more than one screen,
show locations of each on sketch.