STATE WELL REPORT

County: Pearl river Permit #: ______ Driller: Scott Boone Date drilling completed: 06/28/2021

Part 1 Driller's Log

Mississippi Department of Environmental Quality
Office of Land and Water Resources
P.O. Box 2309
Jackson, MS 39225-2309
(601)961-5555

(601)961-5228 (fax)

For Office Use Only:	
Well #: <u>E111</u>	
Aquifer:	
E-Log #:	

State Law requires that this report be prepared by the license holder responsible for the work and filed with the Department at the above address within 30 days of completion of drilling of the well or borehole.

Well Owner Information Well or Borehole Location			
(Landowner if borehole is not for a water well)	Latitude: 30.8353870 Longitude:	-89.7383970	
Owner Name: William lemmons	_		
Mailing Address: 383 Humphrey rd	Method of Lat/Long (check one): Conve	-	
	USGS quad, Hand-held GPS,	Survey-grade GPS	
Poplarville Ms 39470	NE 1/4 NW 1/4, Sec 31	T_02S R_17W	
City State Zip Code	7 miles North east of Bog	ulosa	
Telephone No. (601) 470-5579		(Nearest Town)	
Date drilling started: 06/28/2021 Date drilling completed:		e diameter: <u>7-1/4</u>	
Location of the source of any surface water used for drilli	og: Cropular		
Method of dosing and volume of Chlorine used in drilling a	and development: Granular		
Logs run (check all applicable): No log run Electric Gamma Ray Density Sonic Neutron Other:			
Name of organization running log(s):			
Purpose of borehole (check one): Water Well 🗹 Geotechnical/Geological Investigation Ground Source Heat Pump			
Seismic Survey Other (describe)			
If drilling is not related to water well construction, skip the remainder of this block			
Purpose of Well (check all applicable): Home Industrial Public Supply Irrigation Fish Culture			
Other (describe):			
If a flowing well, method of flow regulation: Valve	Other (describe)		
Static Water Level: 6feet [above or \overline{\subset} below] land surface Date measured: 06/28/2021			
Method of measurement (check one): Steel tapeビElectric			
Well depth: 85 Well grouted to a depth of: 10			
Casing length: 60 feet Casing diameter: 4 inches Type of casing: PVC			
Screen length: 20feet Screen diameter: 4inches Type of screen: Pvc			
Screen slot size: 08 inches Setting depth:	-	feet	
Type of completion (check all applicable): Gravel packed] Underreamed Open hole Natur	ral Development	
Other (describe):		 -	
Top of lap pipe or reduction in casing:feet		RECEIVED	
	one screen describe on next nage	07-23-2021	

County:	Pearl river	
Permit #:		



Fo	or Office Use Only:
Well #:	E111
_	

The sketch below only required for water wells


If well telescopes, show depths on sketch

Ground Level		
	K	

Description of formations encountered must be provided for all wells and boreholes, unless specifically exempted by regulations

Description of Formations Encountered	From (depth)	To (depth)
White chalky clay Peagravel	Ground level	16
Peagravel	16	85
	I	L

If more than one screen, show location of each on sketch

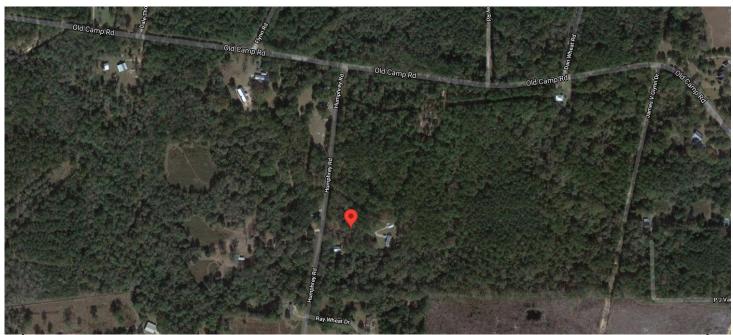

Landowner Name: William lemmons

Print Name of Responsible Licensee and License No.

I HEREBY CERTIFY that the well/borehole was drilled, constructed, and completed in accordance with all applicable requirements of the Mississippi Department of Environmental Quality and the Mississippi Department of Health regulations, if applicable, and state laws.

Scott Boone 6262

07/19/2021

Date

Scott Boone Signature of Licensee

Form: OLWR-SWR-1B (4/13)