

Pearl River
E 2001
10-66

MISSISSIPPI
BOARD OF WATER COMMISSIONERS
416 North State Street
Jackson, Mississippi 39201

WATER WELL DRILLERS LOG

10-13 1966 date well completed
Leo Ladner firm name
Pearl River county well located

LANDOWNER: Bill Williams
Poplarville, Miss

description of formations encountered

from to

Surface	0	2
Clay	2	14
Sand	14	23
White Clay	23	61
Blue Clay	61	87
Blue sand	87	130

(mailing address)

WELL LOCATION:

sec. 8 T 2 N R 17 E
S W
7 miles West of Poplarville
(distance) (direction) (nearest town)

WELL PURPOSE: domestic
(home, irrigation, municipal, industrial)

WELL COMPLETION DATA:

- diameter (inches) 2
- total depth (feet) 130
- static water level (feet) 37 below above top of ground.
- casing 125 (material) (depth)
2" (size) if telescope see back.
- screen 5' (length) 125' (depth to top)
#008 (size) (material)
- pump _____ (HP) _____ (yield gpm)


(type power)
- electric log _____ (yes or no)

(organization running log)
- how well bottom plugged _____

DRILLERS REMARKS:

If well telescopes please sketch and show depths.

GROUND LEVEL

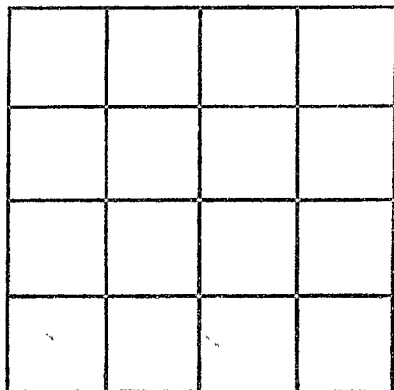

SECTION _____

Please indicate well location X.

ADDITIONAL INFORMATION

If more than one screen, show locations of each on sketch.