

Pearl River
E 2002

MISSISSIPPI
 BOARD OF WATER COMMISSIONERS
 416 North State Street
 Jackson, Mississippi 39201

WATER WELL DRILLERS LOG

Nov. 11 1975 St. Paul Well Dr. Pearl River
 date well completed firm name county well located

LANDOWNER: <u>West Long</u>	description of formations encountered	from	to
(mailing address)			
WELL LOCATION: sec <u>38</u> T <u>2N</u> R <u>12E</u> <u>6</u> miles <u>North</u> of <u>Carroll</u> (distance) (direction) (nearest town)	<u>top soil</u>	<u>0</u>	<u>3</u>
WELL PURPOSE: <u>Home</u> (home, irrigation, municipal, industrial)	<u>clay</u>	<u>3</u>	<u>10</u>
WELL COMPLETION DATA: (1) diameter (inches) <u>4"</u> (2) total depth (feet) <u>205</u> (3) static water level (feet) <u>120</u> (below/above top of ground) (4) casing <u>Plastic</u> , <u>195</u> (material) (depth) <u>4"</u> (size) if telescope see back. (5) screen <u>10ft.</u> , <u>195</u> (length) (depth, to top) <u>4"</u> (size) <u>Plastic</u> (material) (6) pump <u>1/2</u> (HP) <u>10</u> (yield gpm) <u>Elect</u> (type power) (7) electric log <u>yes or no</u> (organization running log) (8) how well bottom plugged <u>Bad</u>	<u>chalk</u>	<u>10</u>	<u>140</u>
	<u>sand</u>	<u>140</u>	<u>155</u>
	<u>chalk</u>	<u>155</u>	<u>190</u>
	<u>sand</u>	<u>190</u>	<u>205</u>

DEPT. OF NATURAL RESOURCES
 BUREAU OF LAND & WATER RESOURCES

JAN 23 1984


RECEIVED

DRILLERS REMARKS:

Jabray Dykes

If well telescopes please sketch and show depths.

GROUND LEVEL

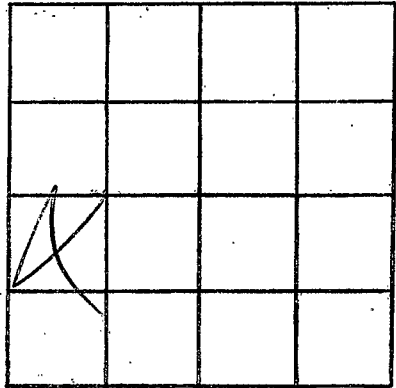

SECTION _____

Please indicate well location X.

ADDITIONAL INFORMATION

If more than one screen,
show locations of each on sketch.