

PEARL RIVER  
E 2003  
11-17-75

MISSISSIPPI  
BOARD OF WATER COMMISSIONERS  
416 North State Street  
Jackson, Mississippi 39201

WATER WELL DRILLERS LOG

11/17 1975 Bud Jester & Son Water Pearl  
date well completed firm name county well located

LANDOWNER: Ford Realty Co. description of formations encountered from to  
Picoque miss Red shale 0 26  
Red & whitened 26 137

(mailing address)

WELL LOCATION:

sec. 17 T 2 N R 17 E  
17 miles N of Picoque  
(distance) (direction) (nearest town)

WELL PURPOSE: home  
(home, irrigation, municipal, industrial)


WELL COMPLETION DATA:

- (1) diameter (inches) 2"
- (2) total depth (feet) 150
- (3) static water level (feet) 61 below above top of ground.
- (4) casing PVC, 150, (material) (depth)  
2" (size) if telescope see back.
- (5) screen 2x10, 140 (length) (depth to top)  
2" (size) PVC (material)
- (6) pump 1 (HP) 450 (yield gpm) Tapm  
elect. (type power)
- (7) electric log no (yes or no)

(organization running log)

(8) how well bottom plugged Sand short

DRILLERS REMARKS:

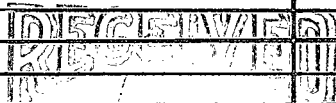

APR 12 1976

If well telescopes please sketch and show depths.

GROUND LEVEL

			X

SECTION \_\_\_\_\_

Please indicate well location X.

ADDITIONAL INFORMATION

If more than one screen, show locations of each on sketch.