

Pearl River  
E 2004  
1/13/76

MISSISSIPPI  
BOARD OF WATER COMMISSIONERS  
416 North State Street  
Jackson, Mississippi 39201

13V

WATER WELL DRILLERS LOG

Jan. 13, 1976 date well completed  
Stofford Well Co. firm name  
Pearl River county well located

LANDOWNER: Claude Morris  
Pt. 2  
Poplarville, Miss  
(mailing address)

description of formations encountered	from	to
<del>top soil</del>	0	2
sandy clay	2	15
chalk	15	85
sand	85	100

WELL LOCATION:  
sect 26 T 2 N R 17 E  
10 miles W of Poplarville  
(distance) (direction) (nearest town)

WELL PURPOSE:  
(home, irrigation, municipal, industrial)

WELL COMPLETION DATA:

(1) diameter (inches) 4"

(2) total depth (feet) 100

(3) static water level (feet) \_\_\_\_\_ below above top of ground.

(4) casing plastic 90ft. (material) (depth)  
4" (size) if telescope see back.

(5) screen 10ft 90 (length) (depth to top)  
4" plastic (size) (material)

(6) pump 1 hp (HP) (yield gpm)  
elect. (type power)

(7) electric log (yes or no)

(organization running log)


(8) how well bottom plugged B.W.U.

DRILLERS REMARKS:  
*[Signature]*

RECEIVED  
OBT - 1 1976  
BOARD OF WATER COMMISSIONERS

If well telescopes please sketch and show depths.

GROUND LEVEL

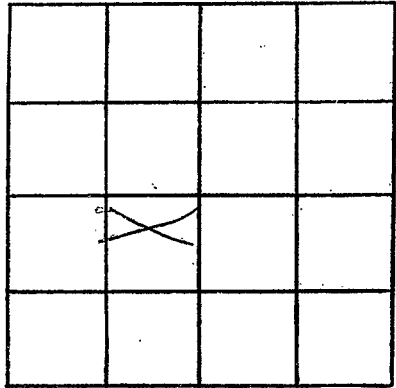

SECTION \_\_\_\_\_

Please indicate well location X.

ADDITIONAL INFORMATION

If more than one screen,  
show locations of each on sketch.