

Pearl
E 2004
12/10/76

MISSISSIPPI
BOARD OF WATER COMMISSIONERS
416 North State Street
Jackson, Mississippi 39201

WATER WELL DRILLERS LOG

12-10 1976 Prouncey water well Pearl River
date well completed firm name county well located

LANDOWNER: MR. WILKES -
REF Poplarville
Ms. 39466
(mailing address)

WELL LOCATION:
sec. 29 T 2 N R 17 E
10 1/2 miles W of Poplarville
(distance) (direction) (nearest town)

WELL PURPOSE: Home
(home, irrigation, municipal, industrial)

WELL COMPLETION DATA:
(1) diameter (inches) 2
(2) total depth (feet) 192
(3) static water level (feet) 63 below top of ground
(4) casing PVC 182 (material) (depth)
2 (size) If telescope see back.
(5) screen 10 182 (length) (depth to top)
2 PVC WRAP (size) (material)
(6) pump 1 9 (HP) (yield gpm)
AC 220V (type power)
(7) electric log (yes or no)
(organization running log)
(8) how well bottom plugged sealed

| description of formations encountered | from | to |
|---------------------------------------|------|-----|
| Clay | 0 | 35 |
| Grey Bluff fine clay | 35 | 140 |
| Red shale | 140 | 160 |
| Clay - fair to good | 160 | 92 |


DRILLERS REMARKS: Casing produced - good

RECEIVED
FEB 18 1977

MISS. Bd. OF WATER COMM

If well telescopes please
sketch and show depths.

GROUND LEVEL

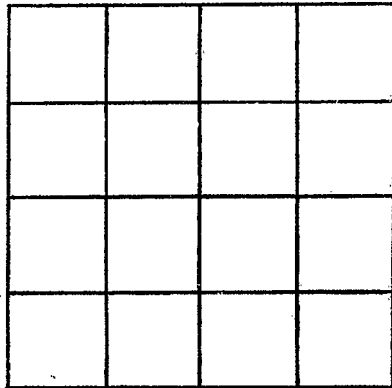

SECTION _____

Please indicate well location X.

ADDITIONAL INFORMATION

If more than one screen,
show locations of each on sketch.