

PEARL RIVER  
E 2000  
2/177

MISSISSIPPI  
BOARD OF WATER COMMISSIONERS  
416 North State Street  
Jackson, Mississippi 39201

WATER WELL DRILLERS LOG

Feb. 19 1977 <sup>13V</sup> Hand Woodward Pearl River  
date well completed firm name county well located

LANDOWNER: Benny Buff  
P.O. Box 114<sup>A</sup> Poplarville, Miss  
(mailing address)

WELL LOCATION:  
sec. 4 T. 2 N. R. 18 W.  
7 miles N of Crossroad  
(distance) (direction) (nearest town)

WELL PURPOSE:  
(home, irrigation, municipal, industrial)

- WELL COMPLETION DATA:
- (1) diameter (inches) 4"
  - (2) total depth (feet) 66
  - (3) static water level (feet) 25 below above top of ground.
  - (4) casing plastic 60ft.  
(material) (depth)
  - 4 if telescope see back.  
(size)
  - (5) screen 6' 60ft.  
(length) (depth to top)
  - (size) (material)
  - (6) pump 1/2 10  
(HP) (yield gpm)
  - 115 AC  
(type power)
  - (7) electric log NO  
(yes or no)
  - Self  
(organization running log)
  - (8) how well bottom plugged 2"SS

description of formations encountered	depth	
	from	to
<u>Red clay</u>	<u>8'</u>	<u>17'</u>
<u>fine sand</u>	<u>18</u>	<u>24</u>
<u>sm. rocks</u>	<u>25</u>	<u>35</u>
<u>Very good sand &amp; gravel</u>	<u>35</u>	<u>66</u>
<u>SS</u>		
<u>AB</u>		
<u>66ft</u>		

RECEIVED


FEB 17 1977

DRILLERS REMARKS:

MISS. DR. [unclear]

If well telescopes please sketch and show depths.

GROUND LEVEL

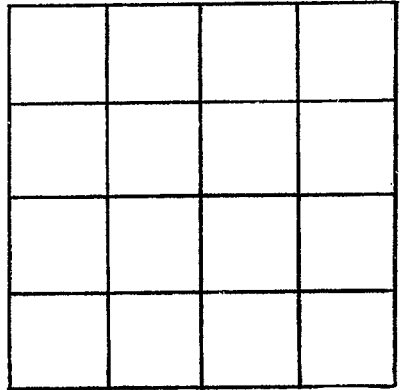

SECTION \_\_\_\_\_

Please indicate well location X.

ADDITIONAL INFORMATION

If more than one screen, show locations of each on sketch.