

Pearl River
E 2008
Mar. 1977

MISSISSIPPI
BOARD OF WATER COMMISSIONERS
416 North State Street
Jackson, Mississippi 39201

WATER WELL DRILLERS LOG

1977 Stafford Well Ser. Pearl River Co.
date well completed firm name county well located


LANDOWNER:	description of formations encountered	from	to
Wynette T LeMaire Poplarville, Miss (mailing address)			
WELL LOCATION:	sandy clay	2	80
sec. <u>23</u> <u>2</u> N R <u>18</u> E <u>8</u> miles <u>W</u> of <u>Poplarville</u> (distance) (direction) (nearest town)	chalk	80	100
WELL PURPOSE: <u>home</u> (home, irrigation, municipal, industrial)	sand & gravel	100	134
WELL COMPLETION DATA:			
(1) diameter (inches) <u>4"</u>			
(2) total depth (feet) <u>134'</u>			
(3) static water level (feet) _____ below above top of ground.			
(4) casing <u>plastic</u> , <u>114</u> (material) (depth) <u>4"</u> (size) If telescope see back.			
(5) screen <u>20ft.</u> , <u>114</u> (length) (depth to top) <u>4"</u> , <u>plastic PVC</u> (size) (material)			
(6) pump _____ (HP) (yield gpm) (type power)			
(7) electric log _____ (yes or no) (organization running log)			
(8) how well bottom plugged <u>B.O.V.</u>			
DRILLERS REMARKS: <u>[Signature]</u>			

RECEIVED
MAR 18 1977

MISS. BD OF WATER COMMISSIONERS

If well telescopes please sketch and show depths.

GROUND LEVEL

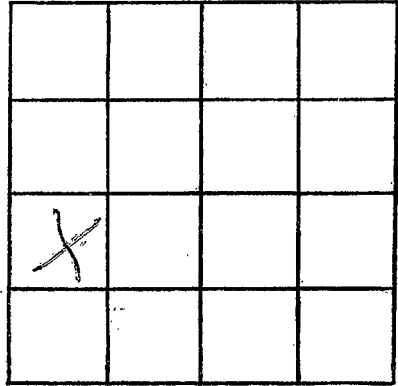

SECTION _____

Please indicate well location X.

ADDITIONAL INFORMATION

If more than one screen,
show locations of each on sketch.