

Pearl River
E 2009
4-16-77

MISSISSIPPI
BOARD OF WATER COMMISSIONERS
416 North State Street
13V Jackson, Mississippi 39201

WATER WELL DRILLERS LOG

4-16 date well completed 1977 ~~Laughlin~~ Pearl River county well located
firm name ~~Laughlin~~ Stockwell Bros.


LANDOWNER:	description of fomations encountered	from	to
Mr. Luke Ballenger Halaleu Meadows, La. (mailing address)			
WELL LOCATION:			
sec. <u>4</u> T. <u>N</u> R. <u>10</u> E. <u>W</u> <u>13</u> miles <u>west</u> of <u>Poplarville</u> (distance) (direction) (nearest town)			
WELL PURPOSE: <u>Home</u> (home, irrigation, municipal, industrial)			
WELL COMPLETION DATA:			
(1) diameter (inches) <u>4"</u>			
(2) total depth (feet) <u>120'</u>			
(3) static water level (feet) <u>60'</u> below top of ground.			
(4) casing <u>P.V.C.</u> , <u>120'</u> (material) (depth) <u>4"</u> If telescope see back. (size)			
(5) screen <u>10'</u> , <u>110'</u> (length) (depth to top) <u>4"</u> , <u>P.V.C.</u> (size) (material)			
(6) pump <u>1</u> , <u>30</u> (HP) (yield gpm) <u>Electric</u> (type power)			
(7) electric log <u>No</u> (yes or no) (organization running log)			
(8) how well bottom plugged <u>Sand</u> <u>Shard</u>			
DRILLERS REMARKS:			

RECEIVED
JUN 17 1977

MISS. BD. OF WATER COMMISSIONERS

If well telescopes please sketch and show depths.

GROUND LEVEL

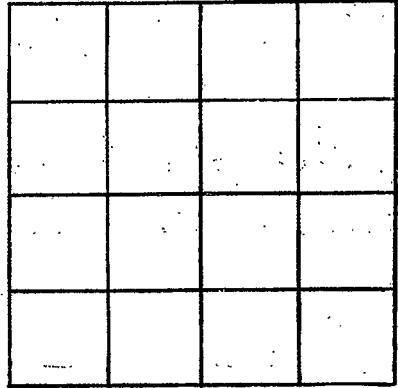

SECTION _____

Please indicate well location X.

ADDITIONAL INFORMATION

If more than one screen,
show locations of each on sketch.