

Pearl River  
~~SE~~ 2010,  
 5-30-77

MISSISSIPPI  
 BOARD OF WATER COMMISSIONERS  
 416 North State Street  
 Jackson, Mississippi 39201

WATER WELL DRILLERS LOG

5-30-1977 Stocktil Bros. Pearl River  
 date well completed firm name county well located

LANDOWNER:  
Mike Harris, Jr.  
Poplarville, Ms.  
 (mailing address)

description of formations encountered	from	to
Clay	0	60
sand	60	135'

WELL LOCATION:  
 sec. 4 T N R E  
2 S 18 W  
1.2 miles West of Poplarville  
 (distance) (direction) (nearest town)

WELL PURPOSE: Home  
 (home, irrigation, municipal, industrial)

- WELL COMPLETION DATA:
- (1) diameter (inches) 4"
  - (2) total depth (feet) 135'
  - (3) static water level (feet) 40' below top of ground.
  - (4) casing PVC, 125'  
 (material) (depth)  
4" if telescope see back.  
 (size)
  - (5) screen 10', 125'  
 (length) (depth to top)  
4", PVC  
 (size) (material)
  - (6) pump 1 30  
 (HP) (yield gpm)  
Elec.  
 (type power)
  - (7) electric log No  
 (yes or no)

(organization running log)

(8) how well bottom plugged

DRILLERS REMARKS: Sand  
Shars


**RECEIVED**

JUN 17 1977

MISS. BD. OF WATER COMMISSIONERS

If well telescopes please sketch and show depths.

GROUND LEVEL

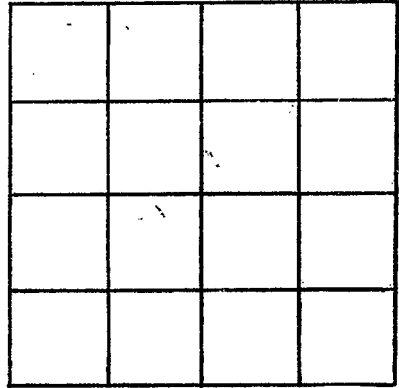

SECTION \_\_\_\_\_

Please indicate well location X.

ADDITIONAL INFORMATION

If more than one screen, show locations of each on sketch.