

PEAR RIVER
E 2012

**MISSISSIPPI
BOARD OF WATER COMMISSIONERS**
416 North State Street
Jackson, Mississippi 39201

WATER WELL DRILLERS LOG

May 20, 1978 78 Linnie Water Well & Pump, Inc. Pearl River
 date well completed firm name county well located

LANDOWNER: <u>Barber Bros.</u>	description of formations encountered	from	to
<u>Route 1</u>			
<u>Carrier, Mississippi</u> (mailing address)	<u>Clay</u>	<u>0</u>	<u>43</u>
WELL LOCATION: sec. <u>31</u> T. <u>72</u> N. R. <u>18</u> E <u>5</u> miles <u>North</u> of <u>White Land</u> (distance) (direction) (nearest town)	<u>Fine Sand</u>	<u>43</u>	<u>133</u>
WELL PURPOSE: <u>Industrial</u> (home, irrigation, municipal, industrial)	<u>Coarse Sand</u>	<u>133</u>	<u>170</u>
WELL COMPLETION DATA:			
(1) diameter (inches) <u>4"</u>			
(2) total depth (feet) <u>170'</u>			
(3) static water level (feet) <u>70'</u> <u>below</u> top of ground. <u>above</u>			
(4) casing <u>P.V.C.</u> <u>160'</u> (material) (depth) <u>4"</u> (size) if telescope see back.			
(5) screen <u>10'</u> <u>160'</u> (length) (depth to top) <u>4"</u> <u>P.V.C.</u> (size) (material)			
(6) pump <u>1</u> <u>17</u> (HP) (yield gpm) <u>Electric</u> (type power)			
(7) electric log <u>no</u> (yes or no)			
(organization running log)			
(8) how well bottom plugged <u>sand sharp</u>			


RECEIVED

MAY 26 1978

DRILLERS REMARKS:

If well telescopes please sketch and show depths.

GROUND LEVEL

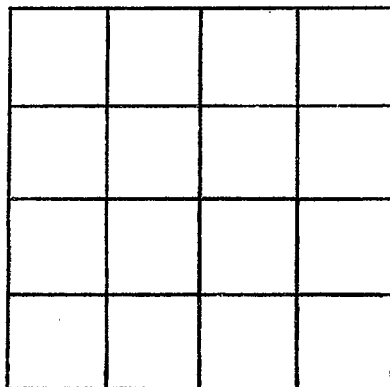

SECTION _____

Please indicate well location X.

ADDITIONAL INFORMATION

If more than one screen,
show locations of each on sketch.