

Pearl River  
E 2013  
8-15-78

MISSISSIPPI  
BOARD OF WATER COMMISSIONERS  
416 North State Street  
Jackson, Mississippi 39201

WATER WELL DRILLERS LOG

Aug. 15 19 78 Stopped Well Pearl River  
date well completed firm name county well located

LANDOWNER: Claude Martin  
Rt. 2, Poplarville, Miss.  
(mailing address)

WELL LOCATION:  
sec. 26 T 2 N R 17 E  
10 miles W of Poplarville  
(distance) (direction) (nearest town)

WELL PURPOSE:  
(home, irrigation, municipal, industrial)

WELL COMPLETION DATA:  
(1) diameter (inches) 4"  
(2) total depth (feet) 120 ft.  
(3) static water level (feet) \_\_\_\_\_ below above top of ground.  
(4) casing plastic, 100 (material) (depth) 4" (size) if telescope see back.  
(5) screen 20 ft., 100 (length) (depth to top) 4" (size) plastic (material)  
(6) pump 1 (HP) (yield gpm) Elect (type power)  
(7) electric log (yes or no)  
(organization running log)  
(8) how well bottom plugged B/w/

description of formations encountered	depth	
	from	to
top soil	0	2
sandy clay	2	15
chalk	15	85
sand	85	110
sand + fine gravel	110	120


DRILLERS REMARKS:  
*[Signature]*

RECEIVED  
AUG 21 1978

MISS. BD. OF WATER COMM

For well telescopes please  
sketch and show depths.

GROUND LEVEL

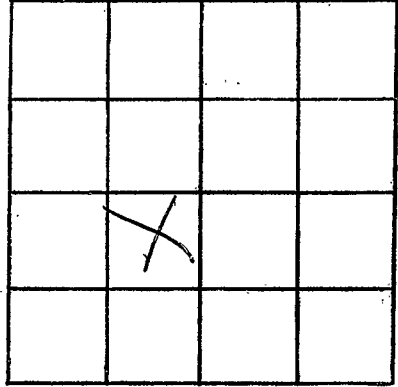

SECTION \_\_\_\_\_

Please indicate well location X.

ADDITIONAL INFORMATION

If more than one screen,  
show locations of each on sketch.