

PEARL RIVER

E 2014

1-09-79

MISSISSIPPI BOARD OF WATER COMMISSIONERS
416 North State Street
Jackson, Mississippi 39201

WATER WELL DRILLERS LOG

Jan 1 1978 Rice Water Well & Pump Inc. Pearl River
Date well completed firm name county well located

LANDOWNER: Henry Holton
Pt. Box
Poplarville, Mo. 39470
(mailing address)

WELL LOCATION:
sec. 27 T 2 N R 17 E
4 miles North of White Sands
(distance) (direction) (nearest town)

WELL PURPOSE: Home
(home, irrigation, municipal, industrial)

WELL COMPLETION DATA:

- (1) diameter (inches) 2"
- (2) total depth (feet) 198'
- (3) static water level (feet) 75' below top of ground.
- (4) casing P.V.C. 188'
(material) (depth)
2" (size) If telescope see back.
- (5) screen 10' 198'
(length) (depth to top)
2" P.V.C.
(size) (material)
- (6) pump 1 8
(HP) (yield gpm)
Electric
(type power)
- (7) electric log No
(yes or no)
(organization running log)

(8) how well bottom plugged
Sand Shrub

DRILLERS REMARKS:


description of formations encountered	from	to
	White Clay	0
Blue Clay	35'	65'
White Clay	65'	105'
Med. White Sand	105'	148'
Coarse White Sand	148'	198'

RECEIVED
JAN 9 1978

MISS. BD. OF WATER COMM.

If well telescopes please sketch and show depths.

GROUND LEVEL

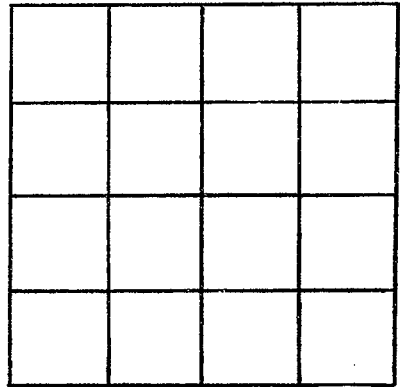

SECTION _____

Please indicate well location X.

ADDITIONAL INFORMATION

If more than one screen, show locations of each on sketch.