

PEARL RIVER

E 2015

2-07-79

MISSISSIPPI BOARD OF WATER COMMISSIONERS 416 North State Street Jackson, Mississippi 39201

WATER WELL DRILLERS LOG

2-7-1979 Red Martin Water Well Pearl River date well completed firm name county well located

LANDOWNER:

John D Humphrey Poplarville Ms R+3, Box 172 (mailing address)

description of formations encountered

from to

Yel clay 0 25 fine sand 25 60 red shalb 60 78 fine sand 78 100 water sand 100 115

WELL LOCATION:

sec 30 T 2 S R 17 E W 16 miles West of Poplarville (distance) (direction) (nearest town)

WELL PURPOSE: Home (home, irrigation, municipal, industrial)

WELL COMPLETION DATA:

- (1) diameter (inches) 4"
(2) total depth (feet) 115'
(3) static water level (feet) 80' below top of ground.
(4) casing PVC (material), 115' (depth)
(5) screen 10' (length), 10.5' (depth to top)
(6) pump 1 (HP), 20 (yield gpm)
(7) electric log (yes or no)
(8) how well bottom plugged 3" sand subs

Miss. Board of Water Comm.


MAR 13 1979

RECEIVED

DRILLERS REMARKS:

If well telescopes please sketch and show depths.

GROUND LEVEL

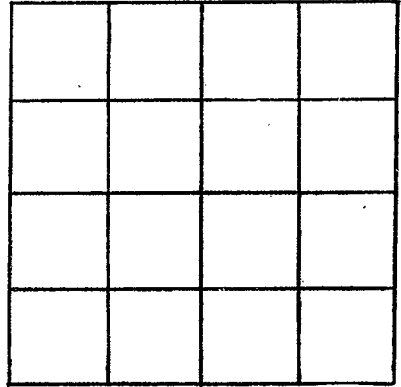

SECTION \_\_\_\_\_

Please indicate well location X.

ADDITIONAL INFORMATION

A series of horizontal lines for entering additional information, starting below the 'ADDITIONAL INFORMATION' header and extending to the bottom of the page.

If more than one screen, show locations of each on sketch.