

| |
|-------------|
| PEARL RIVER |
| E 2017 |
| 7-16-79 |

**MISSISSIPPI
BOARD OF WATER COMMISSIONERS**
416 North State Street
Jackson, Mississippi 39201

WATER WELL DRILLERS LOG

July 19, 1979 19 Dixie Water Well & Pumps Inc. Pearl River
 (date well completed) (firm name) (county well located)

LANDOWNER: Eugene Wheat
RT1 Box 124
Poplarville Ms 39470
 (mailing address)

| description of formations encountered | from | to |
|---------------------------------------|-----------------|-----------|
| | <u>Top Soil</u> | <u>0</u> |
| <u>yellow clay</u> | <u>15</u> | <u>28</u> |
| <u>White Sand</u> | <u>28</u> | <u>58</u> |

WELL LOCATION:
 sec 39 T 2 N R 17 E
5 miles North of Crossroads
 (distance) (direction) (nearest town)

WELL PURPOSE: HOME
 (home, irrigation, municipal, industrial)

- WELL COMPLETION DATA:
- diameter (inches) 2"
 - total depth (feet) 58'
 - static water level (feet) 18' below top of ground.
 - casing PVC 48'
 (material) (depth)
2" if telescope see back.
 (size)
 - screen 10' 58'
 (length) (depth to top)
2" PVC
 (size) (material)
 - pump 1/2 8 GPM
 (HP) (yield/gpm)
Elect
 (type power)
 - electric log NO
 (yes or no)
- (organization running log)
- (8) how well bottom plugged SAND SHAKE

DRILLERS REMARKS:


Miss. Board of Water Comm.

AUG 3 1979

RECEIVED

If well telescopes please sketch and show depths.

GROUND LEVEL

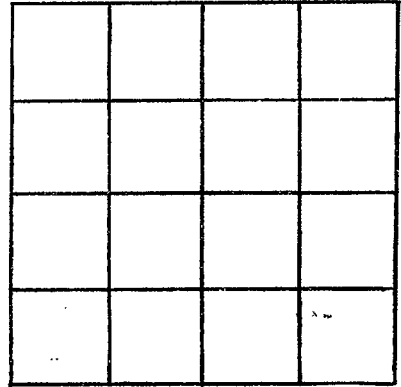

SECTION _____

Please indicate well location X.

ADDITIONAL INFORMATION

If more than one screen,
show locations of each on sketch.