

PEARL RIVER
E 2018
7-29-79

MISSISSIPPI
BOARD OF WATER COMMISSIONERS
416 North State Street
Jackson, Mississippi 39201

WATER WELL DRILLERS LOG

July 29 79 19 Dixie Water Wells Pumping Inc. Pearl River
 date well completed firm name county well located

LANDOWNER: Bob Schmidt
 RT 1 Box 110
 Poplarville MS.
 (mailing address)

description of formations encountered	from	to
	TOP SOIL sandy clay	0
white clay	10	70
white sand	70	120

WELL LOCATION:
 sec. 22 T 2 N R 17 E
 4 miles NORTH of White Sand
 (distance) (direction) (nearest town)

WELL PURPOSE: Home
 (home, irrigation, municipal, industrial)

- WELL COMPLETION DATA:
- diameter (inches) 4"
 - total depth (feet) 120'
 - static water level (feet) 90' below top of ground.
 - casing PVC 100' (material) (depth)
 4" (size) If telescope see back.
 - screen 20' 120' (length) (depth to top)
 4" (size) PVC (material)
 - pump 1 30 (HP) (yield gpm)
 Elect (type power)
 - electric log NO (yes or no)
- (organization running log)
- (8) how well bottom plugged SAND SHARK

Miss. Board of Water Comm.


DRILLERS REMARKS:

AUG 3 1979

RECEIVED

If well telescopes please sketch and show depths.

GROUND LEVEL

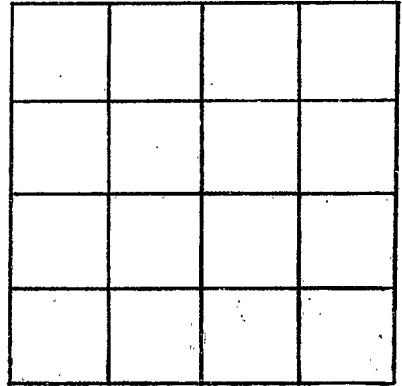

SECTION _____

Please indicate well location X.

ADDITIONAL INFORMATION

If more than one screen,
show locations of each on sketch.