

MISSISSIPPI DEPARTMENT OF NATURAL RESOURCES

BUD PENTON & SONS
WATER WELL SERVICE
 ROUTE 3 BOX 41
 CARRIERE, MS 39220
 PHONE 788-5324

Land and Water Resources
 Southport Mall
 Box 10631
 Jackson, Mississippi 39209

WATER WELL DRILLERS LOG

Real River
E2019
6-23-81

6/23 1981 Penton Pearl River
 date well completed firm name county well located

LANDOWNER: <u>Boyd William</u>	description of formations encountered	from	to
<u>R-T-2 Poplarville</u>			
	<u>Red sand</u>	<u>22</u>	<u>97</u>

(mailing address)

WELL LOCATION:
 sec. 17 T-2 N R-17 E
 S W
18 miles West of Poplarville
 (distance) (direction) (nearest town)

WELL PURPOSE: home
 (home, irrigation, municipal, industrial)

WELL COMPLETION DATA:

- (1) diameter (inches) 4"
- (2) total depth (feet) 97
- (3) static water level (feet) 75 below above top of ground.
- (4) casing pvc 97
 (material) (depth)
- (size) if telescope see back.
- (5) screen 4x10 75
 (length) (depth to top)
- (size) (material)
12 pvc
- (6) pump 1/2 650
 (HP) (yield gpm)
- (type power)
Elect.
- (7) electric log no
 (yes or no)

(organization running log)


(8) how well bottom plugged hard shorb

DRILLERS REMARKS:



If well telescopes please sketch and show depths.

GROUND LEVEL

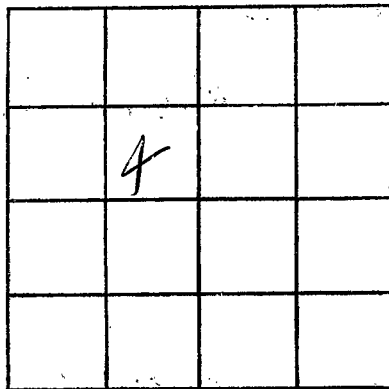

SECTION _____

Please indicate well location X.

ADDITIONAL INFORMATION

If more than one screen,
show locations of each on sketch.