

MISSISSIPPI DEPARTMENT OF NATURAL RESOURCES

Bureau of Land and Water Resources

Southport Mall

P.O. Box 10631

Jackson, Mississippi 39209

WATER WELL DRILLERS LOG

Pearl River
E 2020
7-24-81

BUD PENTON & SON
WATER WELL SERVICE
ROUTE 3 BOX 41
CARRISLE, MS 39426
PHONE 768-5824

Pearl River

7-24 1981
date well completed

county well located

LANDOWNER: David Johns
Poplarville ms

(mailing address)

WELL LOCATION:

sec. 13 T 2 N R. 46 E
5 miles W of Poplarville
(distance) (direction) (nearest town)

WELL PURPOSE: Home
(home, irrigation, municipal, industrial)

WELL COMPLETION DATA:

- (1) diameter (inches) 2
- (2) total depth (feet) 535
- (3) static water level (feet) 190 below above top of ground.
- (4) casing PVC 485 (material) (depth)
- (size) if telescope see back.
- (5) screen 10 485 (length) (depth to top)
- (size) (material) PVC
- (6) pump PL 300 (HP) (yield gpm)
- (type power) elec
- (7) electric log (yes or no)

(organization running log)

(8) how well bottom plugged Seal Blank

DRILLERS REMARKS:

description of formations encountered	from	to
Blue shale	0	120
White sand	120	150
Blue shale	150	485
gray sand	485	535

DEPT. OF NATURAL RESOURCES
BUREAU OF LAND & WATER RESOURCES

NOV 9 1981


RECEIVED

If well telescopes please sketch and show depths.

GROUND LEVEL

0
150
120
180
220
180
120
180
220

*Blue sand
Light blue
Blue sand
Blue sand
Blue sand*

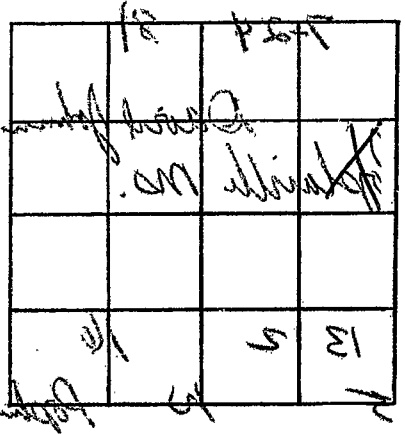

SECTION _____

Please indicate well location X.

ADDITIONAL INFORMATION

5
222
110
222 100
280 01
110
300 4
sub

If more than one screen, show locations of each on sketch.