

Paul River

"E" 2023

Ralph Cotton's
Water Well
Drilling

MISSISSIPPI
BOARD OF WATER COMMISSIONERS
416 North State Street
Jackson, Mississippi 39201

WATER WELL DRILLERS LOG

19 June date well completed
Ralph Cotton's Drilling firm name
Paul River county well located

LANDOWNER:	description of formations encountered	from	to
<u>Kent L Long</u> <u>Poplarville, Miss.</u> (mailing address)			
WELL LOCATION: <u>38 1/2 mi. N of Crossroads</u> <u>Huckberry Rd</u> 300' <u>T</u> 2' <u>N</u> 17' <u>R</u> <u>E</u> ("") (distance) miles (direction) of (nearest town)	<u>blue clay and</u> <u>some stone</u> <u>40-200ft</u>		
WELL PURPOSE: (home, irrigation, municipal, industrial)	<u>col. l. clay</u> <u>200-240ft</u>		
WELL COMPLETION DATA:	<u>1 ft. of sand at 250 ft.</u> <u>(no good bottom)</u>		
(1) diameter (inches) <u>4</u>	<u>much water</u> <u>hard at 320 ft.</u>		
(2) total depth (feet) <u>350</u>	<u>In 30 ft. of water</u> <u>hardly sand.</u>		
(3) static water level (feet) <u>80</u> (below/above top of ground)	<u>Complete well</u> <u>350ft</u>		
(4) casing <u>PVC</u> <u>350</u> (material) (depth)			
(size) if telescope see back.			
(5) screen <u>20</u> <u>330</u> (length) (depth to top)			
(size) (material)			
(6) pump <u>1 sub</u> <u>1500m</u> (HP) (yield gpm)			
<u>220</u> (type power)			
(7) electric log <u>no</u> (yes or no)			
(organization running log)			
(8) how well bottom plugged <u>val</u>			
DRILLERS REMARKS: <u>a real</u> <u>good water</u> <u>supply</u>			


DEPT. OF NATURAL RESOURCES
BUREAU OF LAND & WATER RESOURCES

JAN 23 1984

RECEIVED

If well telescopes please sketch and show depths.

GROUND LEVEL

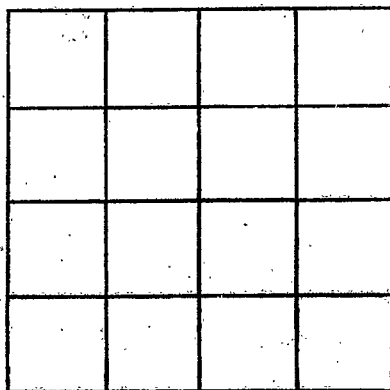

SECTION _____

Please indicate well location X.

ADDITIONAL INFORMATION

If more than one screen, show locations of each on sketch.