

MISSISSIPPI DEPARTMENT OF NATURAL RESOURCES

Bureau of Land and Water Resources

Southport Mall

P.O. Box 10631

Jackson, Mississippi 39209

WATER WELL DRILLERS LOG

Paul Brewer
E
 2024

Feb 17 1982 *William Welby* firm name *Paul Brewer* county well located

| LANDOWNER: <i>James M. Conroy</i> | description of formations encountered | from | to |
|-----------------------------------|---------------------------------------|------------|------------|
| <i>mc nail miss</i> | | | |
| | <i>Red shale</i> | <i>0</i> | <i>36</i> |
| | <i>fine Red sand</i> | <i>36</i> | <i>110</i> |
| | <i>medium sand</i> | <i>110</i> | <i>136</i> |
| | <i>gravel</i> | | |

WELL LOCATION:
 sec. 3 T. 2 N. R. 17 E
8 miles *N* of *Whiteland*
 (distance) (direction) (nearest town)

WELL PURPOSE: *Home*
 (home, irrigation, municipal, industrial)


- WELL COMPLETION DATA:
- (1) diameter (inches) 4"
 - (2) total depth (feet) 136'
 - (3) static water level (feet) 110 below above top of ground.
 - (4) casing pvc 116
 (material) (depth)
 (size) if telescope see back.
 - (5) screen 20 116
 (length) (depth to top)
12 pvc
 (size) (material)
 - (6) pump 1/2 3
 (HP) (yield gpm)
Electric
 (type power)
 - (7) electric log (yes or no) _____
 (organization running log) _____
 - (8) how well bottom plugged Sand
shale

DRILLERS REMARKS: _____

DEPT. OF NATURAL RESOURCES
 BUREAU OF LAND & WATER RESOURCES
 FEB 24 1982
RECEIVED

If well telescopes please sketch and show depths.

GROUND LEVEL

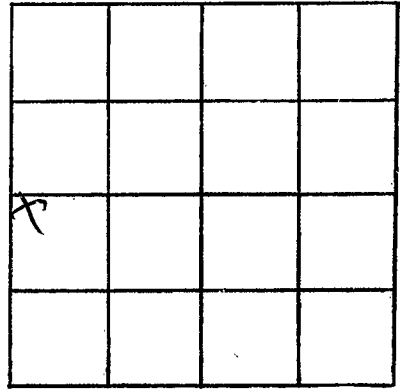

SECTION _____

Please indicate well location X.

ADDITIONAL INFORMATION

If more than one screen, show locations of each on sketch.