

MISSISSIPPI DEPARTMENT OF NATURAL RESOURCES

Bureau of Land and Water Resources

Southport Mall

P.O. Box 10631

Jackson, Mississippi 39209

WATER WELL DRILLERS LOG

Pearl River
E 2025

3-4-82 19 Walker Well Drilling & Repair Pearl River
date well completed firm name county well located

LANDOWNER Bourgeois Contractor Co.
Bourgeois Circle
Bogalusa La
(mailing address)

description of formations encountered	from	to
<u>Red shale</u>	<u>0</u>	<u>18</u>
<u>Heavy block shale</u>	<u>18</u>	<u>25</u>
<u>fine sand</u>	<u>25</u>	<u>40</u>
<u>Coarse sand plus gravel</u>	<u>40</u>	<u>57</u>

WELL LOCATION:
sec 20 T 2 N R 17 E
5 miles W Acorn Road
(distance) (direction) (nearest town)

WELL PURPOSE: Comp
(home, irrigation, municipal, industrial)

- WELL COMPLETION DATA:
- (1) diameter (inches) 2 1/2
 - (2) total depth (feet) 57
 - (3) static water level (feet) 27 below top of ground.
 - (4) casing PVC 47'
(material) (depth)
(size) if telescope see back.
 - (5) screen 10' 47'
(length) (depth to top)
12 slot PVC
(size) (material)
 - (6) pump 1 6
(HP) (yield gpm)
Elec
(type power)
 - (7) electric log (yes or no) _____
(organization running log) _____
 - (8) how well bottom plugged good
about

DRILLERS REMARKS: _____


DEPT. OF NATURAL RESOURCES
BUREAU OF LAND & WATER RESOURCES

APR 6 1982

RECEIVED

If well telescopes please sketch and show depths.

GROUND LEVEL

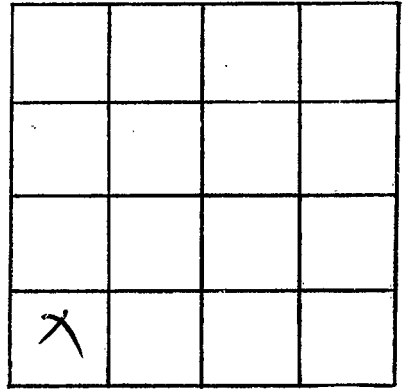

SECTION _____

Please indicate well location X.

ADDITIONAL INFORMATION

If more than one screen,
show locations of each on sketch.