

MISSISSIPPI DEPARTMENT OF NATURAL RESOURCES

Bureau of Land and Water Resources
 Southport Mall WATER WELL SERVICE
 P.O. Box 10631 ROUTE BOX
 Jackson, Mississippi 39209 CARRIERE, MS 39426
 PHONE 798-5324

Paul Rivers
 E
 2024

WATER WELL DRILLERS LOG

BOD PENTON & SON
 WATER WELL SERVICE
 ROUTE BOX 602
 CARRIERE, MS 39426
 PHONE 798-5324

3/1/1982
 date well completed

Paul Rivers
 county well located


LANDOWNER:	description of formations encountered	from	to
<i>Chiles Perez</i> <i>RTA Poplarville Miss</i>	<i>White Shale</i> <i>Blue Sand</i>	<i>0</i>	<i>120</i> <i>120</i>
(mailing address)			
WELL LOCATION: sec. <u>15</u> T. <u>2</u> N. R. <u>17</u> E S W <u>6</u> miles <u>W</u> of <u>Poplarville</u> (distance) (direction) (nearest town)			
WELL PURPOSE: <u>home</u> (home, irrigation, municipal, industrial)			
WELL COMPLETION DATA:			
(1) diameter (inches) <u>2"</u>			
(2) total depth (feet) <u>150</u>			
(3) static water level (feet) <u>26</u> below above top of ground.			
(4) casing <u>PVC</u> , <u>140</u> (material) (depth)			
(size) If telescope see back.			
(5) screen <u>2x10</u> , <u>140</u> (length) (depth to top)			
<u>12</u> , <u>PVC</u> (size) (material)			
(6) pump <u>1/2</u> , <u>450</u> (HP) (yield gpm)			
<u>Elect</u> (type power)			
(7) electric log <u>no</u> (yes or no)			
(organization running log)			
(8) how well bottom plugged <u>hard shorb</u>			

DEPT. OF NATURAL RESOURCES
 BUREAU OF LAND & WATER RESOURCES
 JUL - 1 1982
 RECEIVED

DRILLERS REMARKS:

If well telescopes please sketch and show depths.

GROUND LEVEL

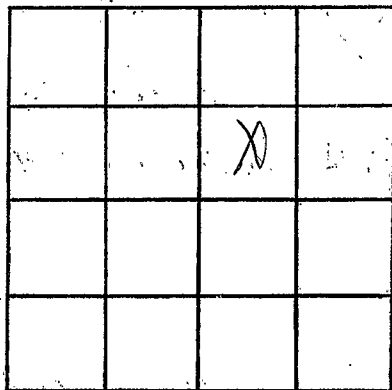

SECTION _____

Please indicate well location X.

ADDITIONAL INFORMATION

If more than one screen,
show locations of each on sketch.