

MISSISSIPPI DEPARTMENT OF NATURAL RESOURCES

Bureau of Land and Water Resources

Southport Mall

P.O. Box 10631

Jackson, Mississippi 39209

WATER WELL DRILLERS LOG

Pearl River  
E 2028  
8-28-82

F/28 1982 Clear Water Drilling Pearl River  
 date well completed firm name county well located

LANDOWNER: Bob Williamson  
Rt. 1  
Poplarville, Ms. 39470  
 (mailing address)

description of formations encountered	from	to
Top Soil	0'	3"
Yellow Sand & Clay	3"	40'
<del>Top Soil</del>		
MED Tan Sand & Clay	40'	45'
MED Tan & yellow Sand	45'	60
MED Tan & yellow Sand some Clay	60	104
MED Tan Sand	104	120
MED Tan & yellow Sand	120	140
MED & LARGE TAN Sand	140	155

WELL LOCATION:  
 sec. 39 T 2 N R 17 E  
 (distance) miles 22 (direction) SW of Poplarville (nearest town)

WELL PURPOSE: Home  
 (home, irrigation, municipal, industrial)

WELL COMPLETION DATA:

(1) diameter (inches) 4

(2) total depth (feet) 155

(3) static water level (feet) 26 below above top of ground.

(4) casing PVC 135  
 (material) (depth)  
 (size) if telescope see back.

(5) screen 20 135  
 (length) (depth to top)  
012 PVC  
 (size) (material)

(6) pump 1 24  
 (HP) (yield gpm)  
220V  
 (type power)

(7) electric log no  
 (yes or no)  
 (organization running log)

(8) how well bottom plugged Sand Sheet

DRILLERS REMARKS:


DEPT. OF NATURAL RESOURCES  
 BUREAU OF LAND & WATER RESOURCES

SEP -7 1982

RECEIVED

If well telescopes please  
sketch and show depths.

GROUND LEVEL

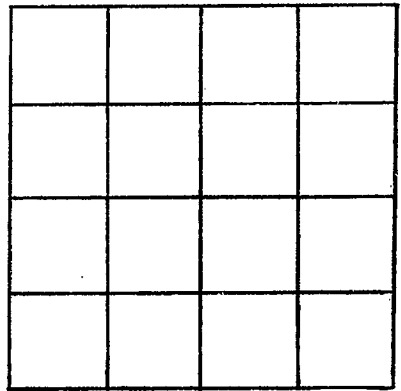

SECTION \_\_\_\_\_

Please indicate well location X.

ADDITIONAL INFORMATION

If more than one screen,  
show locations of each on sketch.