

Pearl River
 E 2029
 8/20/82

MISSISSIPPI DEPARTMENT OF NATURAL RESOURCES
 Bureau of Land and Water Resources
 Southport Mall
 P.O. Box 10631
 Jackson, Mississippi 39209
 WATER WELL DRILLERS LOG

8/20 1982 Clear water drilling Pearl River
 date well completed firm name county well located

LANDOWNER: VAN DUNN
 Rt. 1
 Poplarville Ms. 39470
 (mailing address)

description of formations encountered	from	to
Top Soil	0	4"
Yellow clay	4"	15"
Tan to yellow clay	15"	18"
Tan Sand to clay	18"	30"
Tan sand & yellow clay	30"	50"
Fine to med Tan Sand	50"	100"
Fine-med Tan Sand & clay	100"	105"
Med Sand fine sand	105"	160"

WELL LOCATION:
 sec. 19 T 2 N R 17 E
 20 miles W of Poplarville
 (distance) (direction) (nearest town)

WELL PURPOSE: Home
 (home, irrigation, municipal, industrial)

- WELL COMPLETION DATA:
- (1) diameter (inches) 4
 - (2) total depth (feet) 160
 - (3) static water level (feet) 60 below above top of ground.
 - (4) casing PVC, 140 (material), (depth)
 (size) If telescope see back.
 - (5) screen 20, 140' (length), (depth to top)
 4/2, PVC (size), (material)
 - (6) pump 1, 24 (HP), (yield gpm)
 22V (type power)
 - (7) electric log no (yes or no)
 (organization running log)
 - (8) how well bottom plugged Sand Shale

DRILLERS REMARKS:


DEPT. OF NATURAL RESOURCES
 BUREAU OF LAND & WATER RESOURCES

SEP - 7 1982

RECEIVED

If well telescopes please sketch and show depths.

GROUND LEVEL

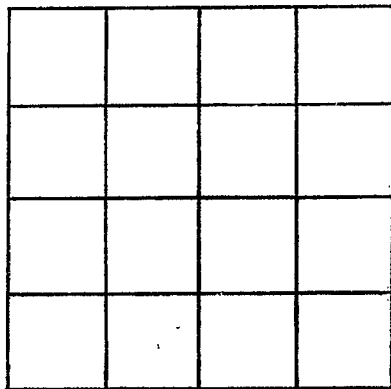

SECTION _____

Please indicate well location X.

ADDITIONAL INFORMATION

If more than one screen, show locations of each on sketch.