

MISSISSIPPI DEPARTMENT OF NATURAL RESOURCES

Bureau of Land and Water Resources

Southport Mall

P.O. Box 10631

Jackson, Mississippi 39209

WATER WELL DRILLERS LOG

Pearl River
E 2030
4/9/83

April 19 1983 date well completed Walker Well Drilling firm name Pearl River county well located

LANDOWNER: Charles Garcia
Part 1 Poplarville Miss
 (mailing address)

Description of formations encountered	from	to
<u>Red shale</u>	<u>0</u>	<u>36</u>
<u>Sand</u>	<u>36</u>	<u>45</u>
<u>Gray shale</u>	<u>45</u>	<u>105</u>
<u>Coar. Sand</u>	<u>105</u>	<u>150</u>

WELL LOCATION:
 sec 17 T 2 N R 17 E
8 miles N Cross Roads
 (distance) (direction) of 26x43
 (nearest town)

WELL PURPOSE: Home
 (home, irrigation, municipal, industrial)

WELL COMPLETION DATA:

(1) diameter (inches) 16"

(2) total depth (feet) 150'

(3) static water level (feet) 120' below top of ground.

(4) casing PVC 140'
 (material) (depth)

_____ If telescope see back.
 (size)

(5) screen 10' 140'
 (length) (depth to top)

12 PVC
 (size) (material)

(6) pump 1/2 8
 (HP) (yield gpm)

Elec
 (type power)

(7) electric log _____
 (yes or no)

_____ (organization running log)

(8) how well bottom plugged Good
shark

DRILLERS REMARKS: _____


DEPT. OF NATURAL RESOURCES
 BUREAU OF LAND & WATER RESOURCES

MAY 20 1983

RECEIVED

If well telescopes please
sketch and show depths.

GROUND LEVEL

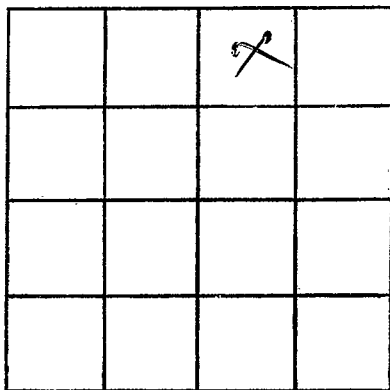

SECTION _____

Please indicate well location X.

ADDITIONAL INFORMATION

If more than one screen,
show locations of each on sketch.