

MISSISSIPPI DEPARTMENT OF NATURAL RESOURCES

Bureau of Land and Water Resources

Southport Mall

P.O. Box 10631

Jackson, Mississippi 39209

WATER WELL DRILLERS LOG

Pearl River  
E 2033

12-7-83 date well completed      Jerry L. Smith firm name      Pearl River county well located

LANDOWNER: Contra subject  
Route 1  
Pap Larnell Miss  
(mailing address)

description of formations encountered	from	to
<u>Sandy Loam</u>	<u>0</u>	<u>2</u>
<u>Soft Gumbo</u>	<u>2</u>	<u>5</u>
<u>Sandy Gumbo</u>	<u>5</u>	<u>40</u>
<u>Shale</u>		
<u>Huge Gumbo</u>	<u>40</u>	<u>50</u>
<u>Soft Gumbo</u>	<u>50</u>	<u>60</u>
<u>Gum.</u>		

WELL LOCATION:  
sec. 15 T 2 N R. 19 E  
S W  
4 1/2 miles NORTH of CROSS ROADS  
(distance) (direction) (nearest town)

WELL PURPOSE: HOME  
(home, irrigation, municipal, industrial)

WELL COMPLETION DATA: 12.8.83

(1) diameter (inches) 2  
(2) total depth (feet) 60  
(3) static water level (feet) 11 below above top of ground.  
(4) casing PVC 50'  
(material) (depth)  
(size) If telescope see back.  
(5) screen 10 PVC  
(length) (depth to top)  
2 ?  
(size) (material)  
(6) pump \_\_\_\_\_  
(HP) (yield gpm)  
(type power)  
(7) electric log \_\_\_\_\_  
(yes or no)  
(organization running log)  
(8) how well bottom plugged  
PVC CAP

DRILLERS REMARKS:


DEPT. OF NATURAL RESOURCES  
BUREAU OF LAND & WATER RESOURCES

FEB 23 1984

RECEIVED

If well telescopes please sketch and show depths.

GROUND LEVEL

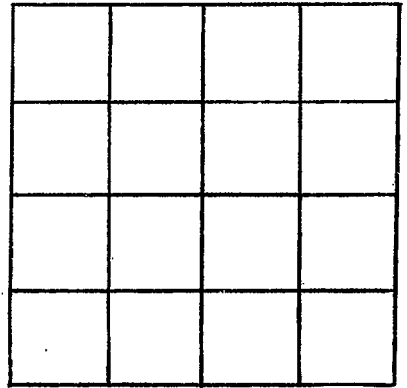

SECTION \_\_\_\_\_

Please indicate well location X.

ADDITIONAL INFORMATION

If more than one screen,  
show locations of each on sketch.