

MISSISSIPPI DEPARTMENT OF NATURAL RESOURCES

Bureau of Land and Water Resources

Southport Mall

P.O. Box 10631

Jackson, Mississippi 39209

WATER WELL DRILLERS LOG

Bad River  
E  
2035

May 16 - 84 19 Walker Welding Bad River  
 date well completed firm name county well located

LANDOWNER: <u>Gregory Spivey</u>	Description of formations encountered	from	to
<u>Papay will man</u>	<u>gray shale</u>	<u>0</u>	<u>12</u>
(mailing address)	<u>sand &amp; gravel</u>	<u>12</u>	<u>30</u>

WELL LOCATION:  
 sec 4 T 2 R 18 W 33  
3 miles N Camp Road  
 (distance) (direction) (nearest town)

WELL PURPOSE: Home  
 (home, irrigation, municipal, industrial)

- WELL COMPLETION DATA:
- (1) diameter (inches) 2"
  - (2) total depth (feet) 30'
  - (3) static water level (feet) 10 below top of ground. above
  - (4) casing PVC, 20'  
 (material) (depth)
  - (size) If telescope see back.
  - (5) screen 10', 20'  
 (length) (depth to top)
  - (size) (material)
  - (6) pump 1/2, 6  
 (HP) (yield gpm)
  - ELC  
 (type power)
  - (7) electric log (yes or no)
  - (organization running log)
  - (8) how well bottom plugged sand  
shook


DRILLERS REMARKS:

DEPT. OF NATURAL RESOURCES  
 BUREAU OF LAND & WATER RESOURCES

JUN 18 1984  
**RECEIVED**

If well telescopes please sketch and show depths.

GROUND LEVEL

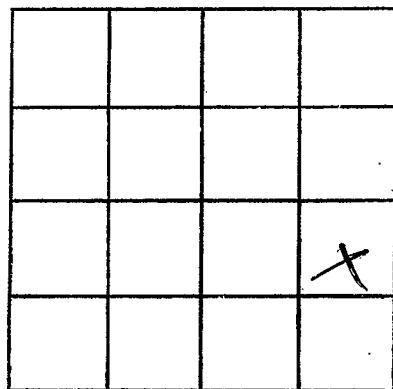

SECTION \_\_\_\_\_

Please indicate well location X.

ADDITIONAL INFORMATION

If more than one screen,  
show locations of each on sketch.