

MISSISSIPPI DEPARTMENT OF NATURAL RESOURCES

Bureau of Land and Water Resources

Southport Mall

P.O. Box 10631

Jackson, Mississippi 39209

Pearl River
E 2037

WATER WELL DRILLERS LOG

BUD SIMON & SON
WATER WELL SERVICE
ROUTE 1 BOX 410
CANTON, MISSISSIPPI 39023
PHONE 782-3224

Pearl River
county well located

8/19 1984
date well completed

LANDOWNER: E H Bruner
R J - 1 Box 115 E
Poplarwill Miss
(mailing address)

description of formations encountered	from	to
<u>Red shale</u>	<u>0</u>	<u>30</u>
<u>Red sand</u>	<u>30</u>	<u>95</u>

WELL LOCATION:
sec. 39 T. 2 N R. 17 E
S W
20 miles N of Southport
(distance) (direction) (nearest town)

WELL PURPOSE: None
(home, irrigation, municipal, industrial)

- WELL COMPLETION DATA:
- (1) diameter (inches) 4"
 - (2) total depth (feet) 95
 - (3) static water level (feet) 40 below top of ground.
 - (4) casing pvc, 95,
(material) (depth)
size if telescope see back.
 - (5) screen 10, 85
(length) (depth to top)
10, pvc
(size) (material)
 - (6) pump 1/2, 800
(HP) (yield gpm)
Elect.
(type power)
 - (7) electric log no
(yes or no)

(organization running log)

(8) how well bottom plugged Shore


DRILLERS REMARKS:

DEPT. OF NATURAL RESOURCES
BUREAU OF LAND & WATER RESOURCES

DEC - 4 1984
RECEIVED

If well telescopes please
sketch and show depths.

GROUND LEVEL

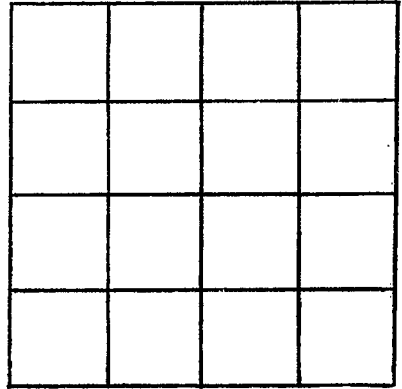

SECTION _____

Please indicate well location X.

ADDITIONAL INFORMATION

If more than one screen,
show locations of each on sketch.