

MISSISSIPPI DEPARTMENT OF NATURAL RESOURCES

Bureau of Land and Water Resources

Southport Mall

P.O. Box 10631

Jackson, Mississippi 39209

WATER WELL DRILLERS LOG

PEARL RIVER  
E 2039

Oct. 19 85, CLEARWATER Drilling PEARL RIVER  
date well completed firm name county well located

LANDOWNER: Pignola  
Hill - FORNER Rd.  
at Whitesands  
Poplarville, Ms. 39470  
(mailing address)

WELL LOCATION:  
sec. 10 T. 2 N R. 17 E  
15 miles W of Poplarville  
(distance) (direction) (nearest town)

WELL PURPOSE: HOME  
(home, irrigation, municipal, industrial)

WELL COMPLETION DATA:

(1) diameter (inches) 4"

(2) total depth (feet) 155'

(3) static water level (feet) 120 (below above top of ground.)

(4) casing SCH 40 PVC, 145'  
(material) (depth)

(size) if telescope see back.

(5) screen 10' 145'  
(length) (depth to top)

4" .010 PVC  
(size) (material)

(6) pump 1/2 12  
(HP) (yield gpm)

220 V  
(type power)

(7) electric log (yes or no)

(organization running log)

(8) how well bottom plugged 55

description of formations encountered	from	to
TOP SOIL	0	6"
yellow clay	6"	20'
pink clay	20'	60'
Red clay	60'	90'
Fine TAN SAND	90'	95'
MED TAN SAND	95'	130'
MED TO coarse sand	130'	135'
MED to FINE SAND	135'	155'
Bluc clay	155'	160'

RECEIVED


JAN 08 1986

Department of Natural Resources  
Bureau of Land & Water Resources

DRILLERS REMARKS:

If well telescopes please  
sketch and show depths.

GROUND LEVEL

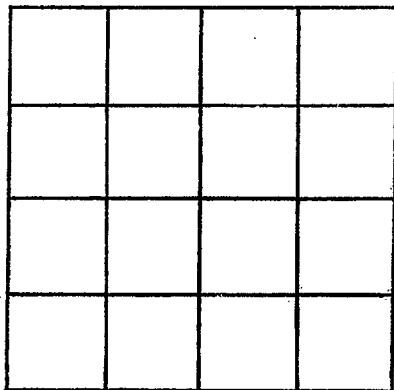

SECTION \_\_\_\_\_

Please indicate well location X.

ADDITIONAL INFORMATION

If more than one screen,  
show locations of each on sketch.