

MISSISSIPPI DEPARTMENT OF NATURAL RESOURCES

Bureau of Land and Water Resources

Southport Mall

P.O. Box 10631

Jackson, Mississippi 39209

WATER WELL DRILLERS LOG

PEARL RIVER
E 2040

Nov. 1985
date well completed

CLEAR WATER DRILLING
firm name

PEARL RIVER
county well located

LANDOWNER: KEOT LANG
Hwy. 43 N., Crossroads
Poplarville, Ms. 39470
(milling address)

description of formations encountered	from	to
Top soil	0	9"
med yellow sand	9"	30
COARSE TAN SAND	30	50
POOR GRAVEL TAN SAND	50	60

WELL LOCATION:
sec. 38 T. 2 N. R. 17 E.
20 miles NW of Poplarville
(distance) (direction) (nearest town)

WELL PURPOSE: HOME
(home, irrigation, municipal, industrial)

- WELL COMPLETION DATA:
- (1) diameter (inches) 2"
 - (2) total depth (feet) 60
 - (3) static water level (feet) 14 below above top of ground.
 - (4) casing PVC 50
(material) (depth)
 if telescope see back.
(size)
 - (5) screen 10 50
(length) (depth to top)
012 PVC
(size) (material)
 - (6) pump Hand
(HP) (yield gpm)

(type power)
 - (7) electric log
(yes or no)

(organization running log)
 - (8) how well bottom plugged SS

RECEIVED


JAN 09 1986

Department of Natural Resources
Bureau of Land & Water Resources

DRILLERS REMARKS:

If well telescopes please sketch and show depths.

GROUND LEVEL

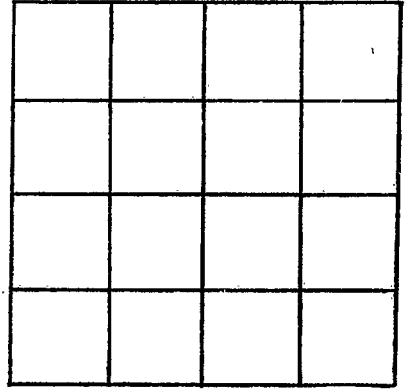

SECTION _____

Please indicate well location X.

ADDITIONAL INFORMATION

If more than one screen, show locations of each on sketch.