

MISSISSIPPI DEPARTMENT OF NATURAL RESOURCES

Bureau of Land and Water Resources

Southport Mall

P.O. Box 10631

Jackson, Mississippi 39209

WATER WELL DRILLERS LOG

Pearl River
Edwards

DEC. 1985
date well completed

CLEAR WATER DRILLING
firm name

PEARL RIVER
county well located

LANDOWNER: H. LAMBERT
Hill-Formed Rd. At Whitesands
Poplarville, Ms 39470
(mailing address)

description of formations encountered

from

to

WELL LOCATION:
sec. 4 T. 2 N. R. 17 E.
17 miles W of Poplarville
(distance) (direction) (nearest town)

<u>TOP</u>	<u>0</u>	<u>4"</u>
<u>yellow sand</u>	<u>4"</u>	<u>12</u>
<u>yellow clay</u>	<u>12</u>	<u>40</u>
<u>CORSE TAN SAND</u>	<u>40</u>	<u>110</u>

WELL PURPOSE: HOME
(home, irrigation, municipal, industrial)

WELL COMPLETION DATA:

- (1) diameter (inches) 4"
- (2) total depth (feet) 110'
- (3) static water level (feet) 80' below top of ground.
- (4) casing Sch 40 PVC, 100'
(material) (depth)

10' if telescope see back.
(size)

- (5) screen 10', 100'
(length) (depth to top)


012, PVC
(size) (material)

- (6) pump 1 hp., 220 V
(HP) (yield gpm) (type power)

- (7) electric log _____
(yes or no)

(organization running log)

- (8) how well bottom plugged SS

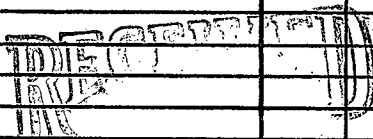


JAN 08 1986

Department: Resources
Bureau of Land & Water Resources

DRILLERS REMARKS:

If well telescopes please
sketch and show depths.

GROUND LEVEL

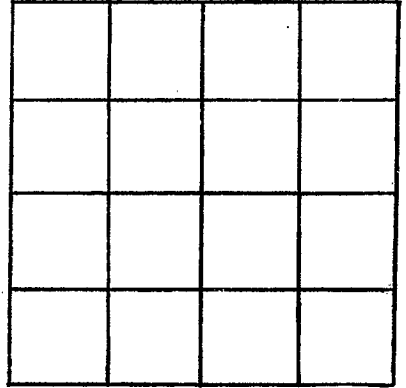

SECTION _____

Please indicate well location X.

ADDITIONAL INFORMATION

If more than one screen,
show locations of each on sketch.