

MISSISSIPPI DEPARTMENT OF NATURAL RESOURCES

Bureau of Land and Water Resources

Southport Mall

P.O. Box 10631

Jackson, Mississippi 39209

WATER WELL DRILLERS LOG

Pearl River
E 2044

April 3 19 86 Walkers Welding Pearl River
date well completed firm name county well located

LANDOWNER: Victor Seals
Rt. 1 Box 144 Poplarville

(mailing address)

WELL LOCATION:


sec. 10 T 2 N R 19 E
miles of
(distance) (direction) (nearest town)

WELL PURPOSE: Home
(home, irrigation, municipal, industrial)

WELL COMPLETION DATA:

- (1) diameter (inches) 4"
- (2) total depth (feet) 80'
- (3) static water level (feet) 60' below above top of ground.
- (4) casing PVC 70'
(material) (depth)
(size) if telescope see back.
- (5) screen 10' 70'
(length) (depth to top)
#8 PVC
(size) (material)
- (6) pump 1/2 8
(HP) (yield gpm)
Electric
(type power)
- (7) electric log (yes or no)
(organization running log)
- (8) how well bottom plugged Sand Shark

description of formations encountered	from	to
	Clay	0
Sand	70	80

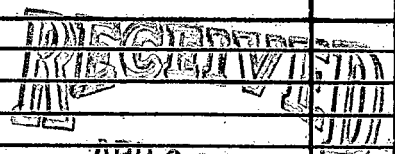


APR 28 1986

Department of Natural Resources
Bureau of Land and Water Resources

DRILLERS REMARKS:

If well telescopes please sketch and show depths.

GROUND LEVEL

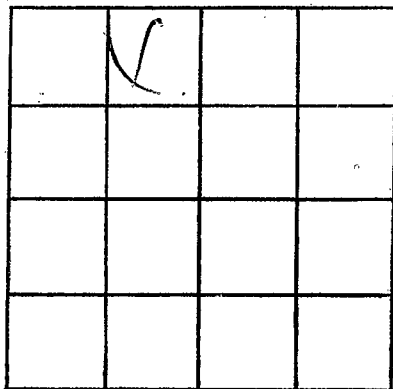

SECTION _____

Please indicate well location X.

ADDITIONAL INFORMATION

If more than one screen,
show locations of each on sketch.