

MISSISSIPPI DEPARTMENT OF NATURAL RESOURCES

Bureau of Land and Water Resources

Southport Mall

P.O. Box 10631


Jackson, Mississippi 39209

WATER WELL DRILLERS LOG

PEARL RIVER  
E 2045

MAY 9 19 86 Walkers Welding Pearl River  
date well completed firm name county well located

LANDOWNER: <u>A.T. Stewart</u> <u>RTI BOX IO7 Poparvil</u> (mailing address)	description of formations encountered	from	to
	<u>Clay</u>	<u>0</u>	<u>I6</u>
	<u>SAND GRAVEL</u>	<u>I6</u>	<u>75</u>
<b>WELL LOCATION:</b>			
sec <u>15T 2 N S</u> R <u>11E W</u>			
<u>25</u> miles <u>NW</u> of <u>Picayune</u> (distance) (direction) (nearest town)			
<b>WELL PURPOSE:</b> <u>Irrigation</u> (home, irrigation, municipal, industrial)			
<b>WELL COMPLETION DATA:</b>			
(1) diameter (inches) <u>4"</u>			
(2) total depth (feet) <u>70'</u>			
(3) static water level (feet) <u>20'</u> below above top of ground.			
(4) casing <u>PVC</u> <u>55'</u> (material) (depth)			
<u>        </u> if telescope see back. (size)			
(5) screen <u>2" IO</u> <u>55'</u> (length) (depth to top)			
<u>#IO</u> <u>PVC</u> (size) (material)			
(6) pump <u>1 1/2</u> <u>30gpm</u> (HP) (yield gpm)			
<u>        </u> (type power)			
(7) electric log <u>        </u> (yes or no)			
<u>        </u> (organization running log)			
(8) how well bottom plugged <u>Sand Shark</u>			
<b>DRILLERS REMARKS:</b>			

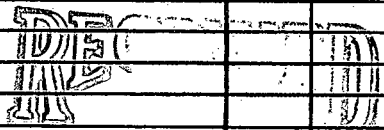


MAY 9 1986

Department of Natural Resources  
Bureau of Land & Water Resources

If well telescopes please sketch and show depths.

GROUND LEVEL

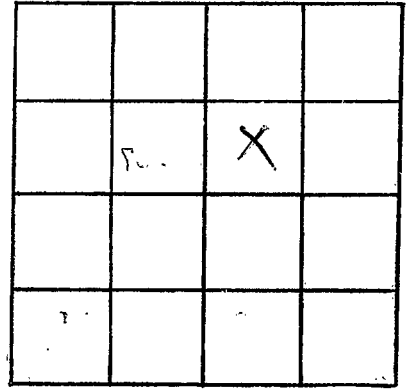

SECTION \_\_\_\_\_

Please indicate well location X.

ADDITIONAL INFORMATION

If more than one screen,  
show locations of each on sketch.