

MISSISSIPPI DEPARTMENT OF NATURAL RESOURCES

Bureau of Land and Water Resources

P.O. Box 10631

Jackson, Mississippi 39209

WATER WELL DRILLERS LOG

COUNTY WELL LOCATED PEARCE RIVER	
WELL NUMBER E	CODED
2048	
DATE WELL COMPLETED 11-21-87	

PERMIT NUMBER 0-928
NAME OF DRILLING FIRM WALKER'S WELL DRILLING

NAME & MAILING ADDRESS OF LANDOWNER THOMAS L. Disolot		
2410 CRAIN ST		
SLIDEELL LA.		
WELL LOCATION: SEC	TOWNSHIP	RANGE
30	2	N 19 E
DISTANCE	DIRECTION	NEAREST TOWN
7 Miles	N	of CROSSROAD'S
OTHER LANDMARK CROSSROAD'S MISS.		
WELL PURPOSE: <input checked="" type="checkbox"/> Home Irrigation, <input type="checkbox"/> Municipal, <input type="checkbox"/> Industrial, <input type="checkbox"/> Fish Pond, etc.		

PUMP DATA		
PUMP TYPE (Circle One): <input checked="" type="checkbox"/> Submersible, <input type="checkbox"/> Turbine, <input checked="" type="checkbox"/> Flowing Well, Other (Describe) _____		
POWER TYPE (Circle One): <input checked="" type="checkbox"/> Electric, <input type="checkbox"/> Tractor, <input type="checkbox"/> Diesel, <input type="checkbox"/> Gasoline, <input type="checkbox"/> Butane, Other (Describe) _____		
Pump Capacity (GPM) 8	No. of Stages 8	Setting Depth 100 FT.
PUMP TEST		
Well yielded _____ GPM with a drawdown of _____ ft. after _____ hours of pumping		

WELL DATA		
Well Depth 90'	Casing Diameter (In.) 4"	Casing Length (Ft.) 85'
Type of Casing PVC	Hole Depth 91'	Depth to Static Water Level 60
TYPE OF COMPLETION: (Circle One or More): <input checked="" type="checkbox"/> Gravel Packed, <input type="checkbox"/> Underreamed, <input type="checkbox"/> Telescoped, <input checked="" type="checkbox"/> Natural Development, <input type="checkbox"/> Open Hole, <input type="checkbox"/> Other (Describe) AIR		
Top of Lap Pipe or Reduction in Casing FEET <input type="checkbox"/> IF TELESCOPED OR MORE THAN ONE SCREEN: USE BACK PAGE		

LOG DATA	
TYPE OF LOG RUN (Circle One): <input checked="" type="checkbox"/> No Log Run, Electric, Gamma Ray, Density, Sonic, Neutron, Other (Describe) _____	
Name of Organization Running Log	

SCREEN DATA		
Diameter - Inches 4"	Length - Feet 5'	Slot Size - Inches #10
Screen Type J. WRAP	Depth to Bottom - Feet 90'	


GEOLOGIC DATA (Office Use Only)			
Surface Elev.	Geologic Unit	Unit Thickness	Depth to Top
Subs. SWL	Date	Analysis	Aquifer Test
Driller's Remarks RECEIVED JAN 11 1988			

DESCRIPTION OF FORMATIONS ENCOUNTERED	FROM	TO	FORMATIONS (Continued)	FROM	TO
REDCRAY	0	30	Department of Natural Resources Bureau of Land & Water Resources		
RED SAND	30	50			
WHITE SAND	50	70			
COARSE WHITE SAND	70	90			

IF MORE SPACE IS NEEDED, USE BACK

If well telescopes please sketch and show depths.

GROUND LEVEL

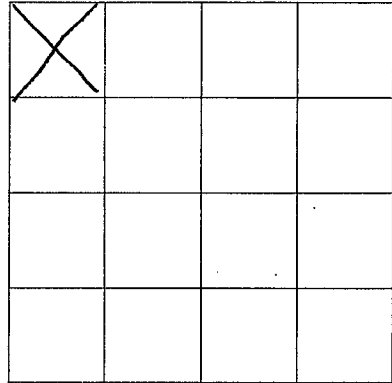

SECTION _____

Please indicate well location X.

ADDITIONAL INFORMATION

If more than one screen,
show location of each on sketch.