

## MISSISSIPPI DEPARTMENT OF NATURAL RESOURCES

Bureau of Land and Water Resources

Southport Mall

P.O. Box 10631

Jackson, Mississippi 39209

## WATER WELL DRILLERS LOG

P. River  
E 2049  
9/8 1987 Bud Benton Pearl River  
 date well completed firm name county well located  
Watts Well Service

LANDOWNER: Brian Bubrey description of formations encountered from to  
Buras to RT Box 462 Red Shell 0 40  
Red Sand 40 80  
White Shell 80 95  
Red Sand 95 140  
 (mailing address)

WELL LOCATION:  
 sec. 19 T 2 N R 17 E  
 S W  
12 miles North Crossroad  
 (distance) (direction) of (nearest town)

WELL PURPOSE: home  
 (home, irrigation, municipal, industrial)

## WELL COMPLETION DATA:

- (1) diameter (inches) 4"  
 (2) total depth (feet) 140  
 (3) static water level (feet) 42 below above  
 top of ground.  
 (4) casing PVC 130  
 (material) (depth)  
20 If telescope see back.  
 (size)  
 (5) screen 10 130  
 (length) (depth to top)  
1/2 PVC  
 (size) (material)  
 (6) pump 1/2 600  
 (HP) (yield gpm)  
Elect  
 (type power)  
 (7) electric log NO  
 (yes or no)

(organization running log)

(8) how well bottom plugged hard

DRILLERS REMARKS:

RECEIVED


APR 14 1988

Supplemental to Mississippi Department of Natural Resources  
 Bureau of Land and Water Resources



If well telescopes please  
sketch and show depths.

GROUND LEVEL

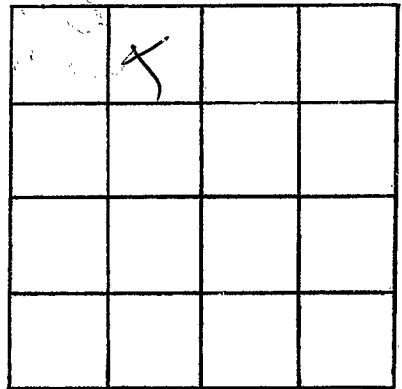

SECTION \_\_\_\_\_

Please indicate well location X.

ADDITIONAL INFORMATION

If more than one screen,  
show locations of each on sketch.