

MISSISSIPPI DEPARTMENT OF NATURAL RESOURCES

Bureau of Land and Water Resources

P.O. Box 10631

Jackson, Mississippi 39209

WATER WELL DRILLERS' ORGANIZATION

COUNTY WELL LOCATED  
Pearl River

WELL NUMBER  
E  
2053

CODED

DATE WELL COMPLETED  
7-1-90

PERMIT NUMBER  
~~0-519~~ 0-519

NAME OF DRILLING FIRM  
Walker Well Service

NAME & MAILING ADDRESS OF LANDOWNER  
Barbara J. Beck  
Rt. 1 Box 1406  
Poplarville, Ms. 39426

WELL LOCATION: SEC 30 TOWNSHIP 2 N RANGE 19 E

DISTANCE 6 Miles DIRECTION NORTH of CROSSROAD NEAREST TOWN

OTHER LANDMARK  
CROSSROADS MS.

WELL PURPOSE: Home, Irrigation, Municipal, Industrial, Fish Pond, etc.

PUMP DATA

PUMP TYPE (Circle One):  
Submersible Turbine, Jet, Flowing Well,  
Other (Describe)

POWER TYPE (Circle One):  
Electric Tractor, Diesel, Gasoline, Butane,  
Other (Describe) H/P

Pump Capacity (GPM) 12 No. of Stages 8 Setting Depth 100 FT.

PUMP TEST  
Well yielded \_\_\_\_\_ GPM with  
a drawdown of \_\_\_\_\_ ft.  
after \_\_\_\_\_ hours of pumping

WELL DATA

Well Depth 120	Casing Diameter (In.) 4	Casing Length (Ft.) 120
Type of Casing PVC	Hole Depth 120	Depth to Static Water Level 80

TYPE OF COMPLETION: (Circle One or More):  
Gravel Packed, Underreamed, Telescoped,  
Natural Development, Open Hole, Other  
(Describe) an

Top of Lap Pipe or Reduction in Casing  
FEET IF TELESCOPED OR MORE THAN ONE SCREEN: USE BACK PAGE

LOG DATA

TYPE OF LOG RUN (Circle One):  
No Log Run, Electric, Gamma Ray, Density, Sonic, Neutron,  
Other (Describe)

Name of Organization Running Log


SCREEN DATA

Diameter - Inches 4	Length - Feet 10	Slot Size - Inches #10
Screen Type Slot	Depth to Bottom - Feet 120	

GEOLOGIC DATA (Office Use Only)

Surface Elev.	Geologic Unit	Unit Thickness	Depth to Top
Subs. SWL	Date	Analysis	Aquifer Test


Driller's Remarks

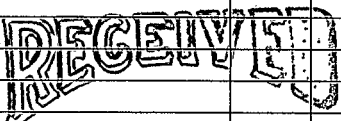DESCRIPTION OF FORMATIONS ENCOUNTERED	FROM	TO	FORMATIONS (Continued)	FROM	TO
Sand	0	20	 AUG 14 1990 Department of Natural Resources Bureau of Land & Water Resources		
Clay	20	40			
Sand	40	72			
White Clay	72	90			
Sand Rocks	90	120			

IF MORE SPACE IS NEEDED, USE BACK

If well telescopes please sketch and show depths.

GROUND LEVEL

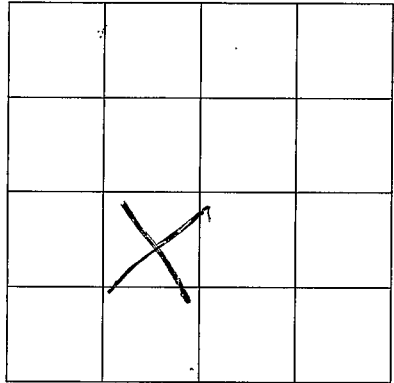

SECTION \_\_\_\_\_

Please indicate well location X.

ADDITIONAL INFORMATION

If more than one screen,  
show location of each on sketch.