

P. RIVER
E 2054

MISSISSIPPI DEPARTMENT OF NATURAL RESOURCES
Bureau of Land and Water Resources
Southport Mall
P.O. Box 10631
Jackson, Mississippi 39209
WATER WELL DRILLERS LOG

2/10/1991 Clear Water Drilling Pool River
date well completed firm name county well located

LANDOWNER: Edward J Wislaw
Wheilan
P.O. Box 284
Poplarville Mo 39470
(mailing address)

description of formations encountered	from	to
Top	0	6"
yellow clay	6"	5'
tan sand & gravel	5'	35'
Blue clay	35'	190'
tan sand	190'	220'


WELL LOCATION:
sec. 15 T 9 N R 18 E
15 miles (distance) of Poplarville (nearest town)

WELL PURPOSE: HOME
(home, irrigation, municipal, industrial)

WELL COMPLETION DATA:

- (1) diameter (inches) 2"
- (2) total depth (feet) 220
- (3) static water level (feet) 17' below top of ground.
- (4) casing PVC 210' (material), (depth)
- if telescope see back.
- (5) screen 10' 210' (length), (depth to top)
- 1 1/2" PVC (size), (material)
- (6) pump 1/2 HP 0.5 (yield gpm)
- 230V (type power)
- (7) electric log (yes or no)
- (organization running log)
- (8) how well bottom plugged B.C.O.


DRILLERS REMARKS:

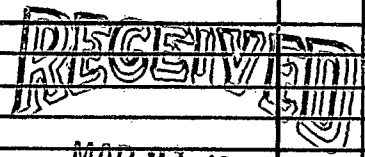

Dept. of Environmental Quality
Bureau of Land & Water Resources

If well telescopes please sketch and show depths.

GROUND LEVEL

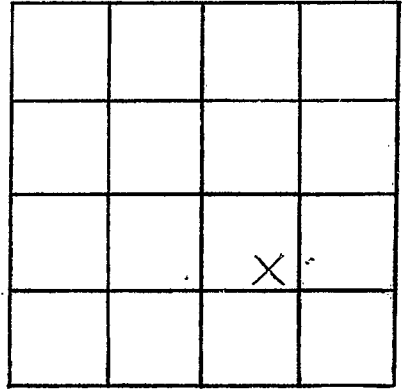

SECTION 15

Please indicate well location X.

ADDITIONAL INFORMATION

If more than one screen,
show locations of each on sketch.