

MISSISSIPPI DEPARTMENT OF NATURAL RESOURCES

Bureau of Land and Water Resources

Southport Mall

P.O. Box 10631

Jackson, Mississippi 39209

WATER WELL DRILLERS LOG

P. RIVER
E 2059

2/21

91 Bad Porter

Pearl River

date well completed

firm name

county well located

LANDOWNER: MARCE Whead

Old Rd RT-3 Box 244

Poplarville Miss
(mailing address)

description of formations encountered	from	to
Red shale	0	10
sand gravel	10	60
Blue shale	60	103
White sand	103	140
Blue shale	140	555
gray sand	555	585

WELL LOCATION:

sec. 4 T. 2 N. R. 18 E. S. W
1 miles N of CROSS Rd
(distance) (direction) (nearest town)

WELL PURPOSE: drinking
(home, irrigation, municipal, industrial)


WELL COMPLETION DATA:

- (1) diameter (inches) 14 "
- (2) total depth (feet) 585
- (3) static water level (feet) 12 below top of ground.
- (4) casing PVC, 585
(material) (depth)
(size) if telescope see back.
- (5) screen 20, 565
(length) (depth to top)
12, PVC
(size) (material)
- (6) pump _____ (HP) _____ (yield gpm)
(type power)
- (7) electric log no
(yes or no)

(organization running log)

(8) how well bottom plugged standard

DRILLERS REMARKS:

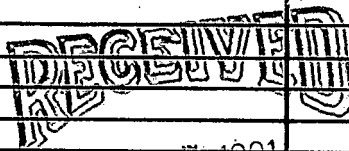

JUN 7 1991

Dept. of Environmental Quality
Bureau of Land & Water Resources

If well telescopes please sketch and show depths.

GROUND LEVEL

X			

SECTION _____

Please indicate well location X.

ADDITIONAL INFORMATION

If more than one screen, show locations of each on sketch.