

MISSISSIPPI DEPARTMENT OF NATURAL RESOURCES

Bureau of Land and Water Resources

Southport Mall

P.O. Box 10631

Jackson, Mississippi 39209

WATER WELL DRILLERS LOG

| |
|----------|
| P. RIVER |
| E 2058 |
| |
| |

2/21 date well completed 19 91 Red perter firm name Pearl River county well located


LANDOWNER: Narvel Wheat
Cons Rd R.T. Box 244A
Poplarville Miss.
 (mailing address)

| description of formations encountered | from | to |
|---------------------------------------|------|-----|
| Red shale | 0 | 10 |
| Sand gravel | 10 | 60 |
| Blue shale | 60 | 103 |
| white sand | 103 | 140 |
| Blue shale | 140 | 560 |
| Grey sand | 560 | 606 |

WELL LOCATION:
 sec. 4 T 2 N R. 18 E
 S W
1 miles N of Cons Rd
 (distance) (direction) (nearest town)

WELL PURPOSE: fresh water
 (home, irrigation, municipal, industrial)

- WELL COMPLETION DATA:
- diameter (inches) 4
 - total depth (feet) 605
 - static water level (feet) flow below top of ground.
 - casing pvc 605
 (material) (depth)
 (size) if telescope see back.
 - screen 20 585
 (length) (depth to top)
12
 (size) (material)
 - pump flow
 (HP) (yield gpm)
 (type power)
 - electric log no
 (yes or no)
 (organization running log)
 - how well bottom plugged Sand

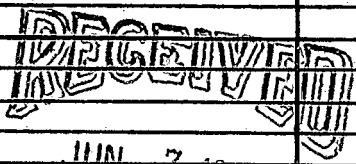


JUN 7 1991

Dept. of Environmental Quality
 Bureau of Land & Water Resources

DRILLERS REMARKS: Shock

If well telescopes please sketch and show depths.

GROUND LEVEL

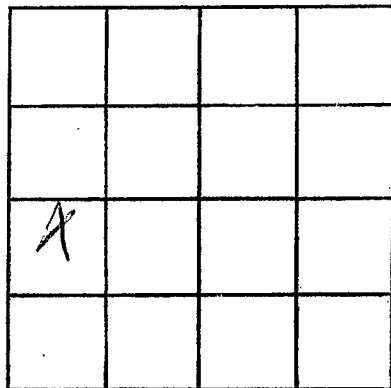

SECTION _____

Please indicate well location X.

ADDITIONAL INFORMATION

If more than one screen, show locations of each on sketch.