

PEARL RIVER
E 2065
7-6-79

3

MISSISSIPPI
BOARD OF WATER COMMISSIONERS
416 North State Street
Jackson, Mississippi 39201

WATER WELL DRILLERS LOG

July 6, 1979 19 Dixie Water Well Pump, Inc. Pearl River
 date well completed firm name county well located

LANDOWNER: BOWLADE
Const. Co., Bonregard Circle
Bogalusa Ln. 70427
 (mailing address)

description of formations encountered	depth	
	from	to
Red Sand Top Soil	0	15"
Yellow Clay	15	29
Red Sand & GRAVEL	29	65
White coarse SAND	65	133

WELL LOCATION:
 sec. 20 T. 2 N R. 17 E
4 miles North of Crossroads
 (distance) (direction) (nearest town)

WELL PURPOSE: home
 (home, irrigation, municipal, industrial)

- WELL COMPLETION DATA:
- diameter (inches) 2"
 - total depth (feet) 133
 - static water level (feet) 55 below top of ground.
 - casing PVC 123'
 (material) (depth)
2" if telescope see back.
 (size)
 - screen 10' 133'
 (length) (depth to top)
2" PVC
 (size) (material)
 - pump _____
 (HP) (yield gpm)

 (type power)
 - electric log NO
 (yes or no)

 (organization running log)
 - how well bottom plugged
SAND SHARK

Miss. Board of Water Comm.


AUG 8 1979

DRILLERS REMARKS:

RECEIVED

If well telescopes please sketch and show depths.

GROUND LEVEL

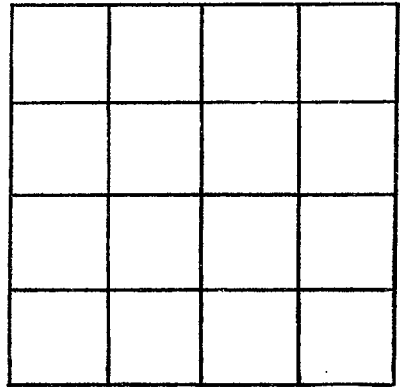

SECTION _____

Please indicate well location X.

ADDITIONAL INFORMATION

If more than one screen,
show locations of each on sketch.