

P.R.
 F6
 1-2-75

MISSISSIPPI
 BOARD OF WATER COMMISSIONERS
 416 North State Street
 Jackson, Mississippi 39201

WATER WELL DRILLERS LOG CODED

1-2 1975 Lumpkin Well Ser. Paul River
 date well completed firm name county well located

LANDOWNER:	description of formations encountered	from	to
<u>Johnny Morris</u> <u>Poplarville, Miss.</u> (mailing address)			
WELL LOCATION:			
sec. <u>9</u> T. <u>2</u> N. R. <u>10</u> E <u>5</u> miles <u>West</u> of <u>Poplarville</u> (distance) (direction) (nearest town)			
WELL PURPOSE: <u>Home</u> (home, irrigation, municipal, industrial)			
WELL COMPLETION DATA:			
(1) diameter (inches) <u>2"</u>			
(2) total depth (feet) <u>131'</u>			
(3) static water level (feet) <u>80'</u> below top of ground.			
(4) casing <u>P.V.C.</u> , <u>126'</u> (material) (depth) <u>2"</u> (size) If telescope see back.			
(5) screen <u>5'</u> , <u>126'</u> (length) (depth to top) <u>2"</u> , <u>P.V.C.</u> (size) (material)			
(6) pump <u>1</u> , <u>600 G.P.H.</u> (HP) (yield gpm) <u>Elec.</u> (type power)			
(7) electric log <u>No</u> (yes or no)			
(organization running log)			
(8) how well bottom plugged <u>Sand Mash</u>			
DRILLERS REMARKS:			

CODED

RECEIVED


JAN 22 1975

MISS. BO. C.

COMM

If well telescopes please sketch and show depths.

GROUND LEVEL

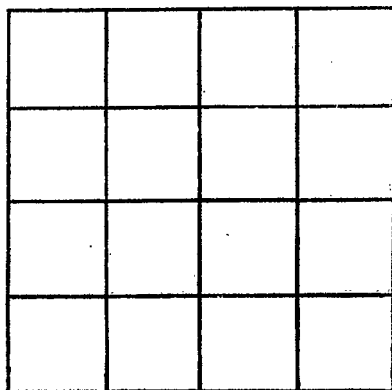

SECTION _____

Please indicate well location X.

ADDITIONAL INFORMATION

If more than one screen,
show locations of each on sketch.