

CODED

CODED

MISSISSIPPI
 BOARD OF WATER COMMISSIONERS
 416 North State Street
 Jackson, Mississippi 39201

WATER WELL DRILLERS LOG

Pearl River
F 9
12-18-69

12-18-69 19
 date well completed

Evelyn Stafford Water Well Service
 firm name

Pearl River
 county well located

LANDOWNER: H. C. Bass

description of formations encountered

from

to

306 North Jackson
Poplarville, Miss. 39470
 (mailing address)

Chalk

0

65 ft

WELL LOCATION:

sec. 32 T 2 S R 16 E W
6 miles W of Poplarville
 (distance) (direction) (nearest town)

Sand

60

138 ft

WELL PURPOSE:

(home, irrigation, municipal, industrial)

WELL COMPLETION DATA:

- (1) diameter (inches) 4 in
- (2) total depth (feet) 138 ft
- (3) static water level (feet) 90 below above top of ground.
- (4) casing Plastic, 1.38,
 (material) (depth)
4 in if telescope see back.
 (size)
- (5) screen 30 ft, 109 ft
 (length) (depth to top)
4, Plastic
 (size) (material)
- (6) pump 2, 3600 hr
 (HP) (yield gpm)
Elec
 (type power)
- (7) electric log NO
 (yes or no)

(organization running log)

(8) how well bottom plugged BWV

DEC 29 1969


MISS. BD. OF
 WATER COMMISSIONERS

DRILLERS REMARKS:

Charles Stafford

If well telescopes please sketch and show depths.

GROUND LEVEL

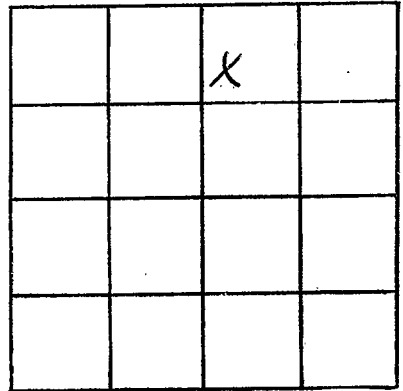

SECTION _____

Please indicate well location X.

ADDITIONAL INFORMATION

If more than one screen, show locations of each on sketch.